





20
15
10
5
0
-5
-10

15
10
5
0
-5
-10

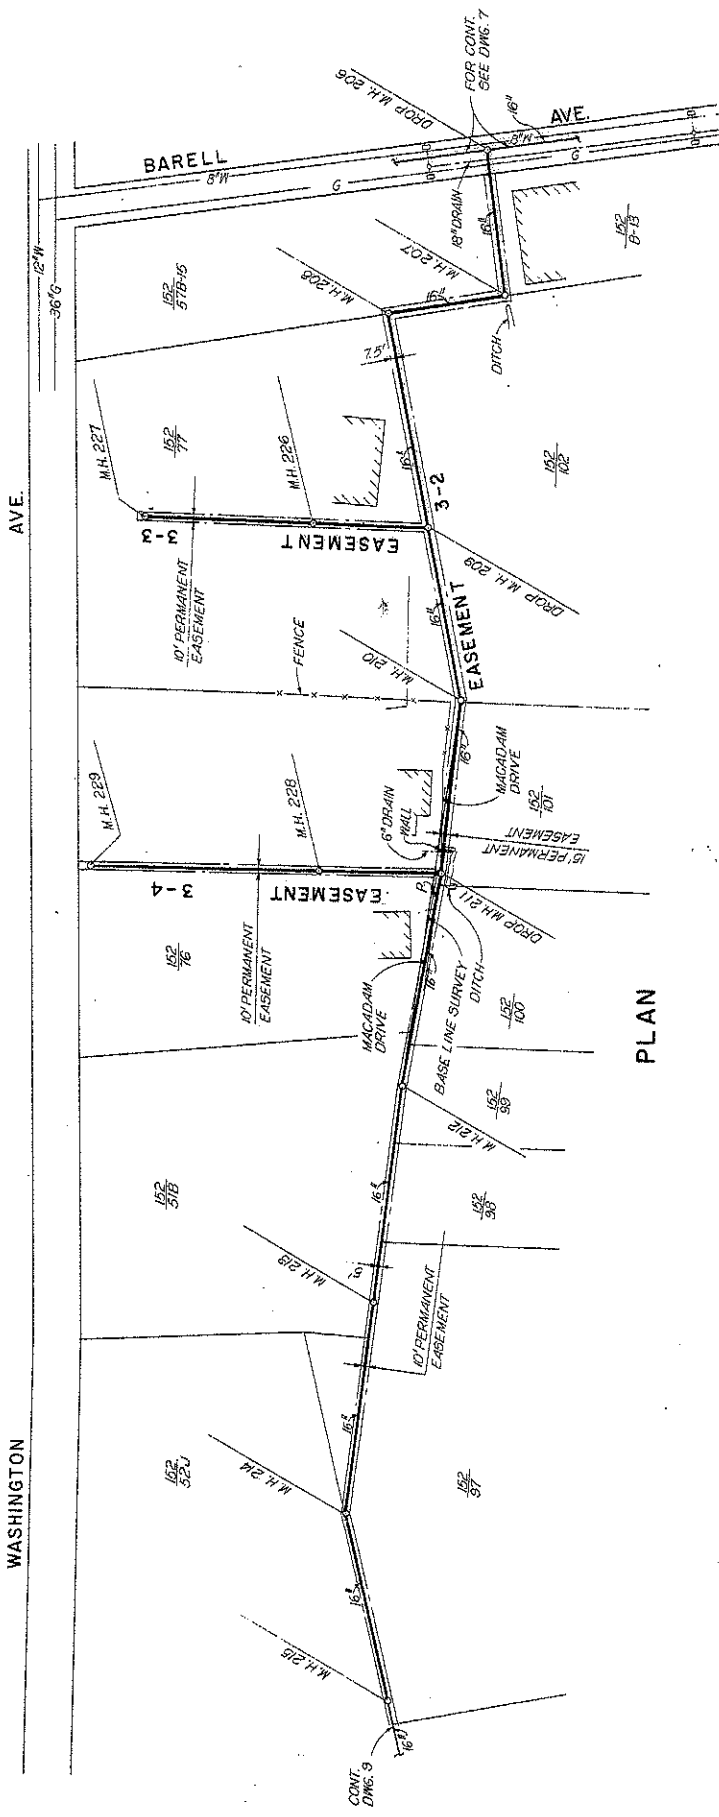

PLAN

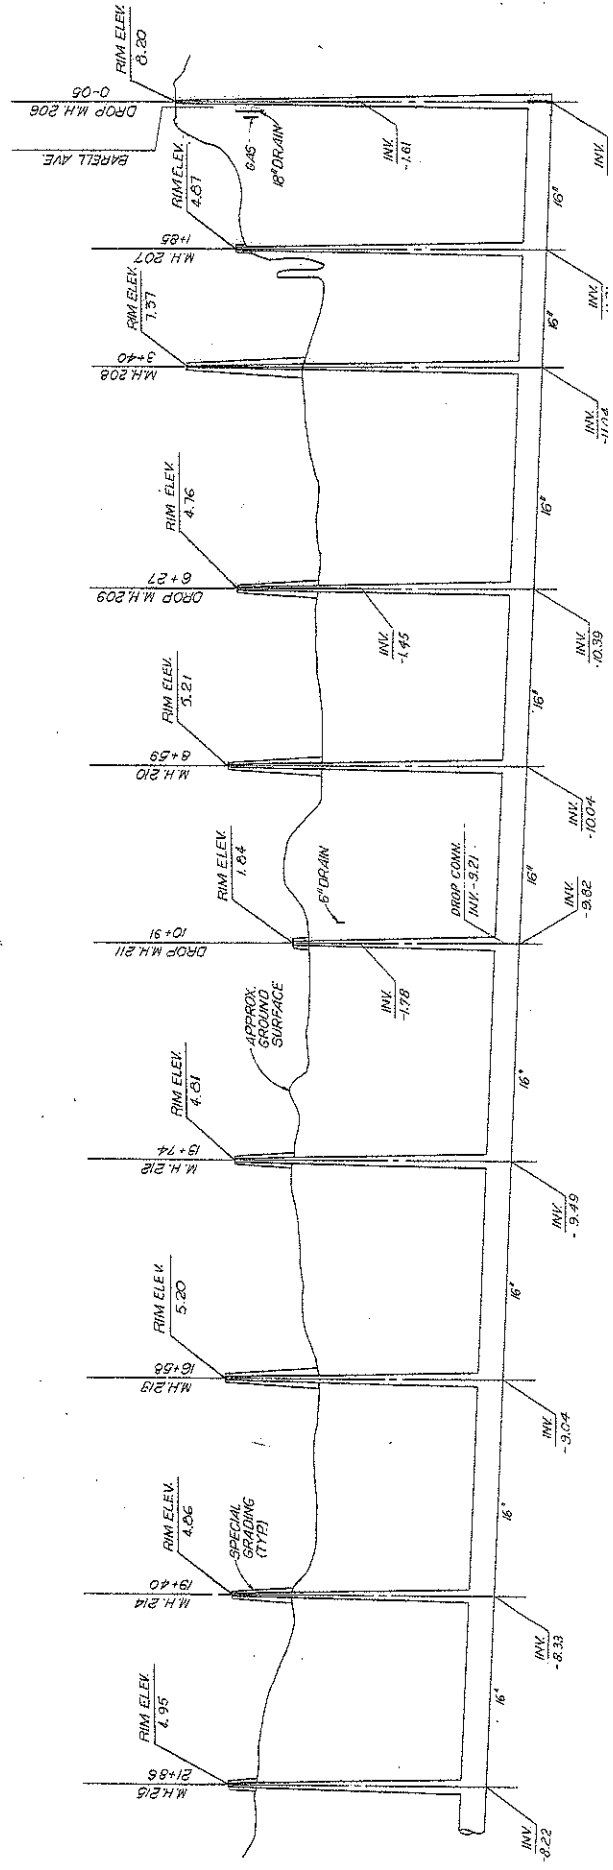

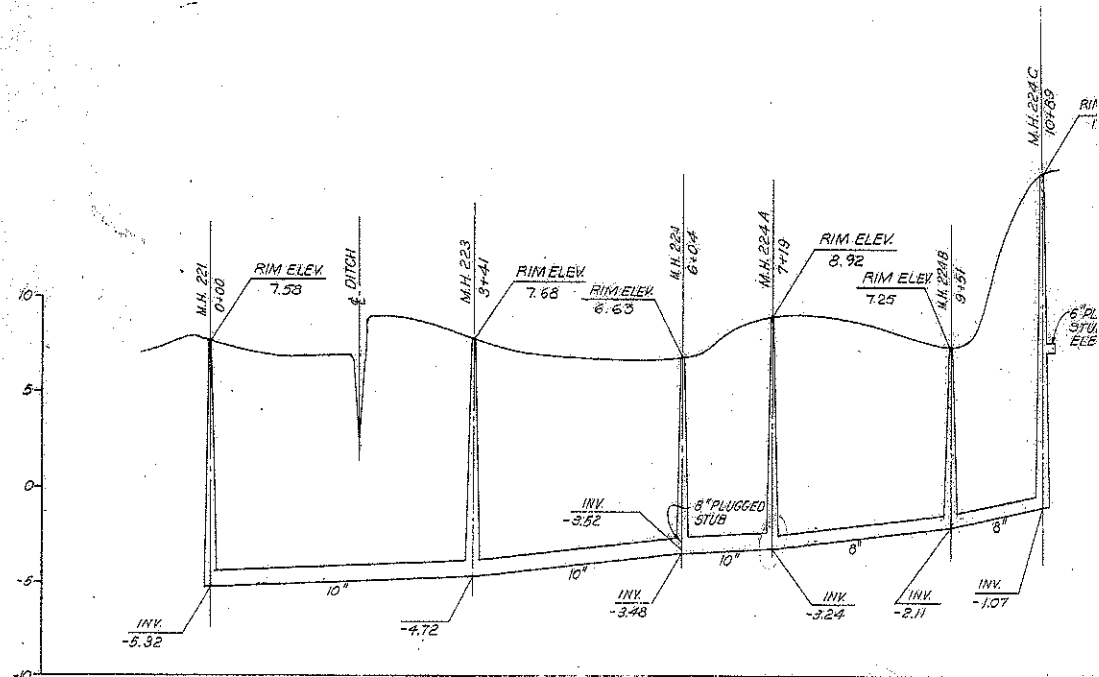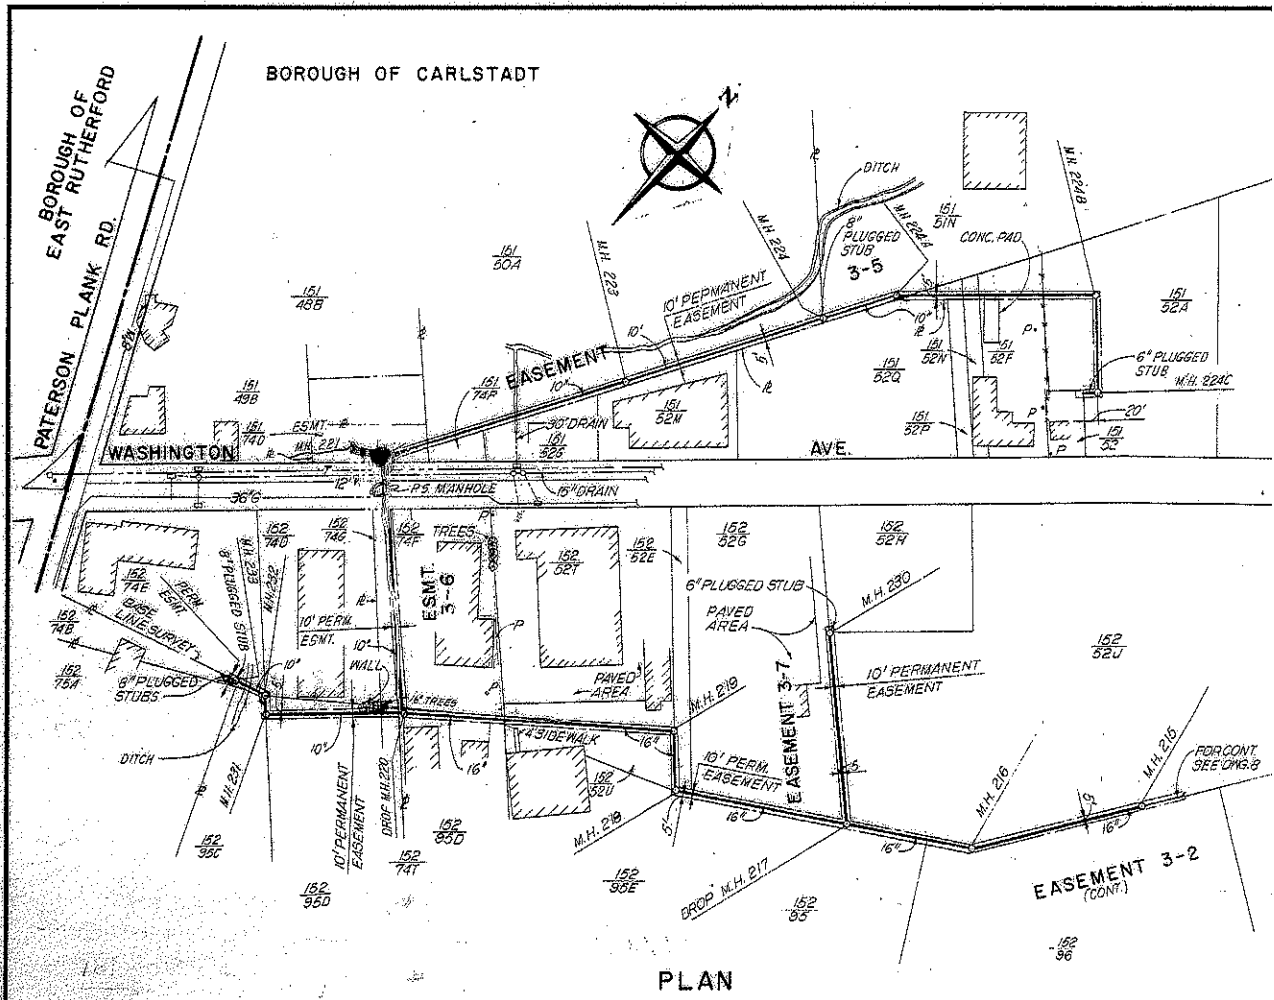


CLINTON BOGERT ASSOCIATES
CONSULTING ENGINEERS


DESIGNED H.L./W.E.
DRAWN E.A.
CHECKED P.E.

RECORD DRAWING-APRIL, 1973
APPROVED BY: *[Signature]*


CARLSTADT 5

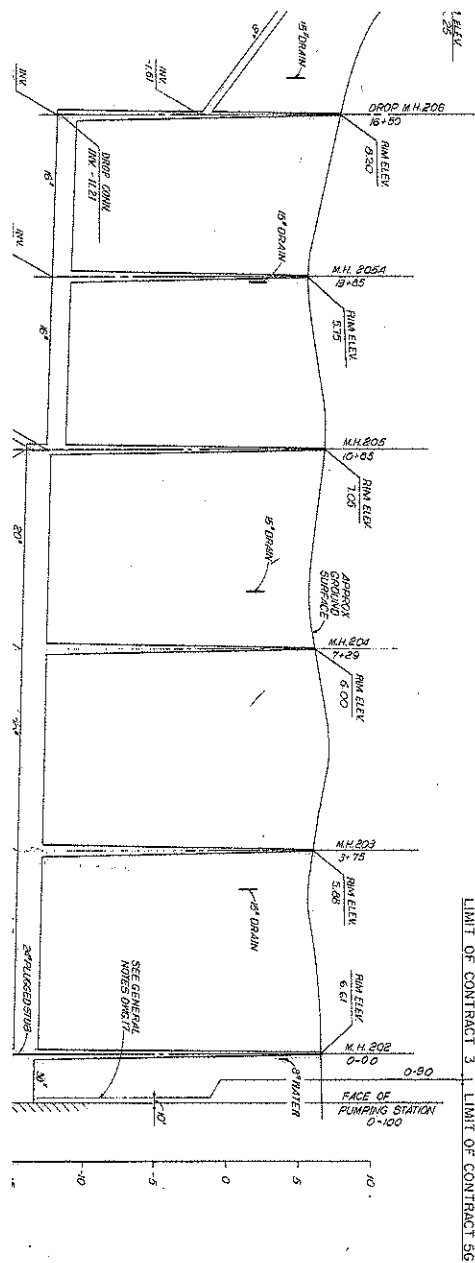


PLAN

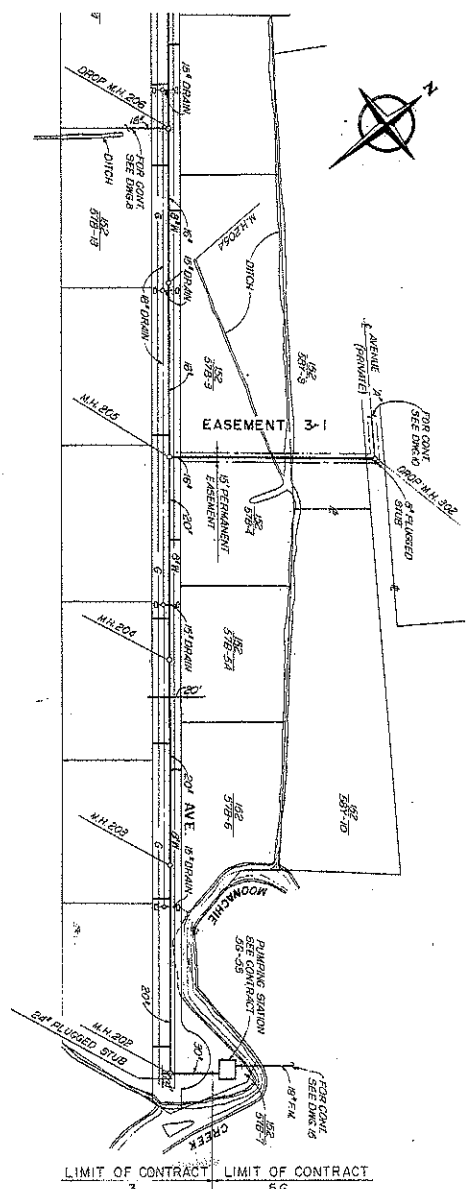


EASEMENT 3-1

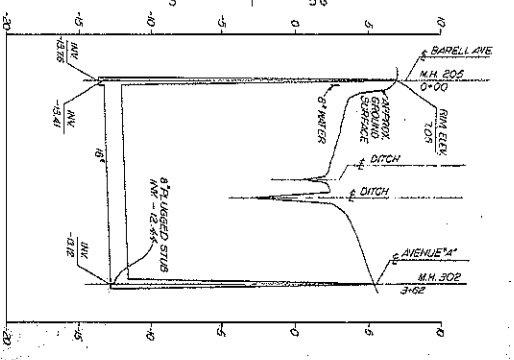

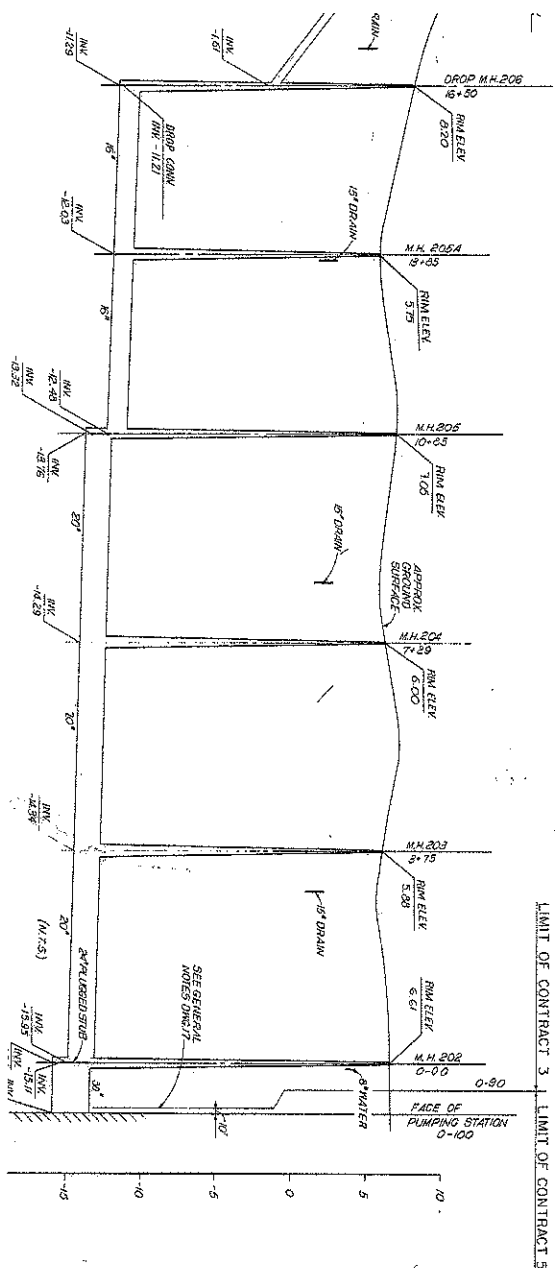

PLAN

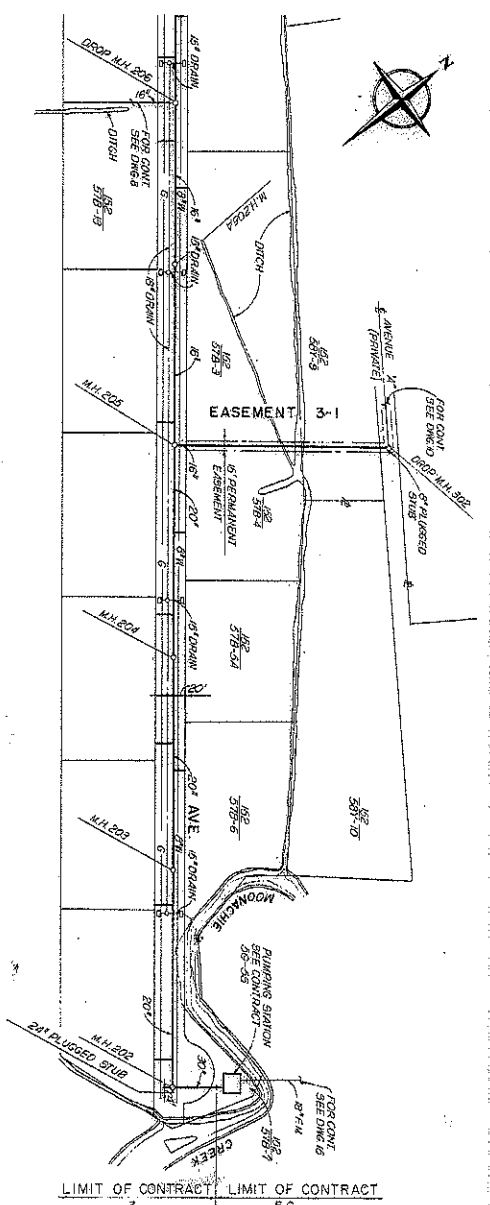


EASEMENT 3-1




LIMIT OF CONTRACT 3 LIMIT OF CONTRACT 35

LIMIT OF CONTRACT LIMIT OF CONTRACT

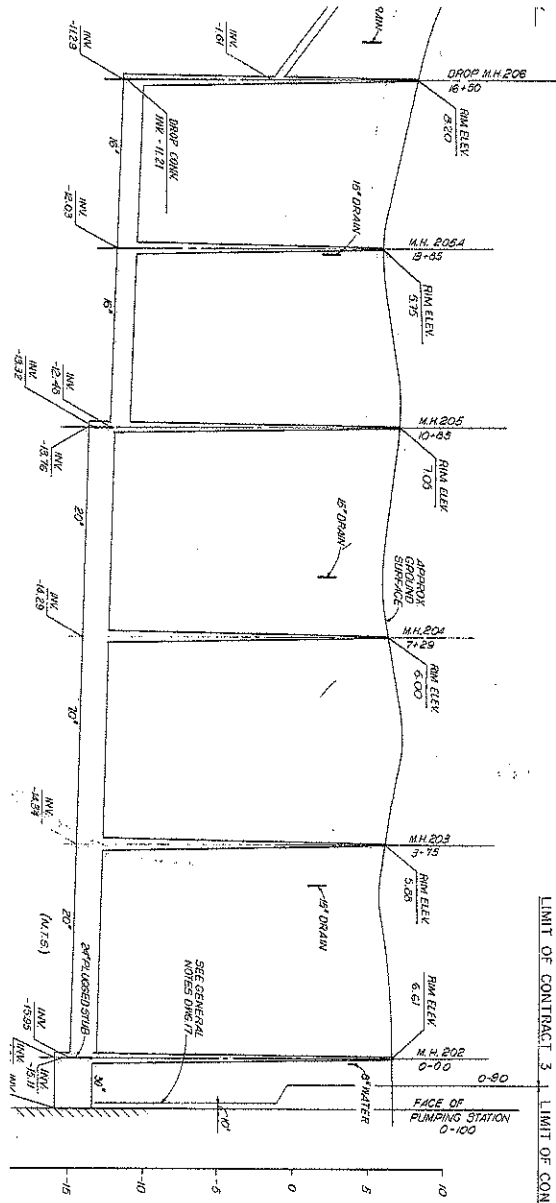



LIMIT OF CONTRACT 3 1 LIMIT OF CONTRACT 5G

PLAN

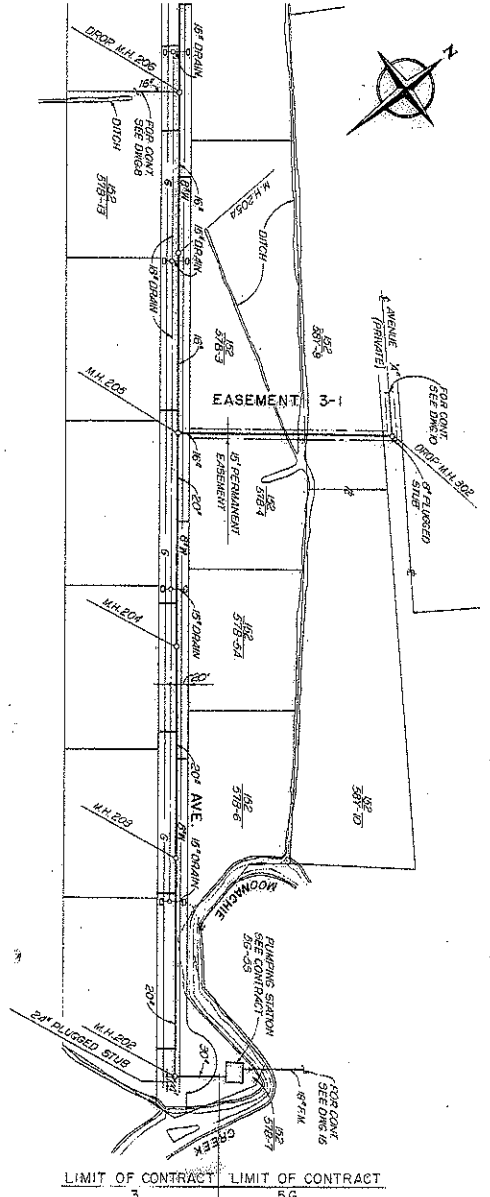


EASEMENT 3-1

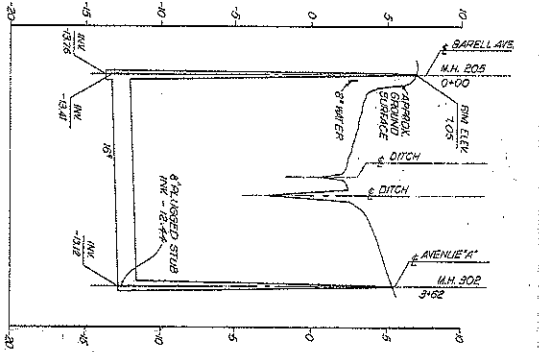



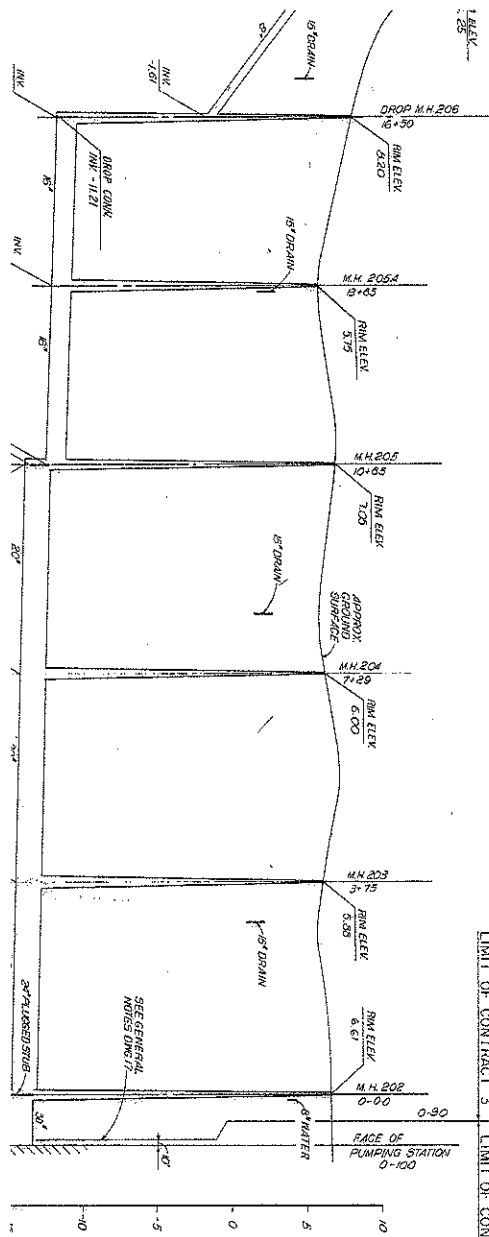


LIMIT OF CONTRACT 3 LIMIT OF CONTRACT 5G

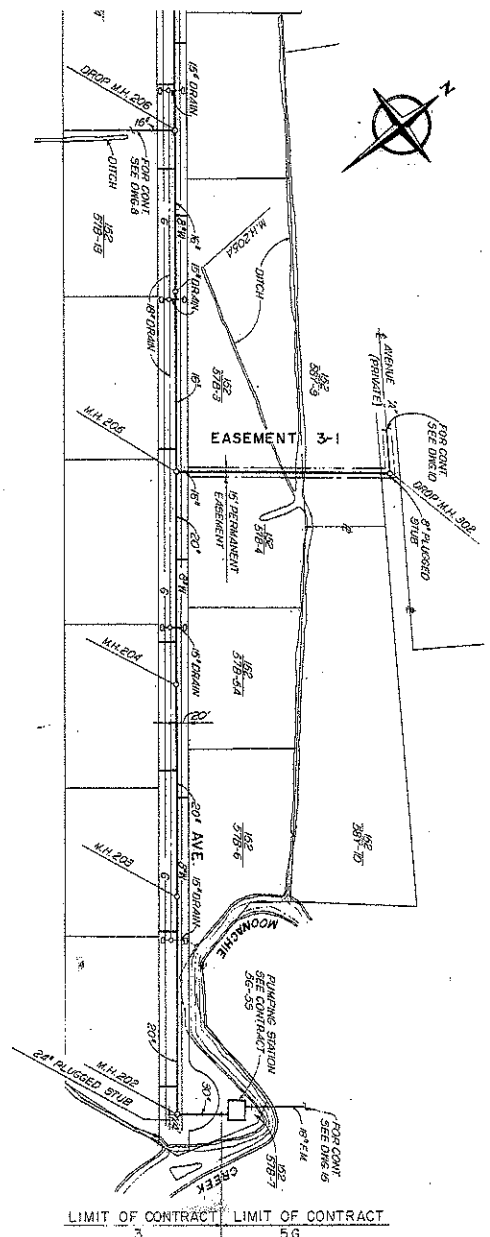


EASEMENT 3-1

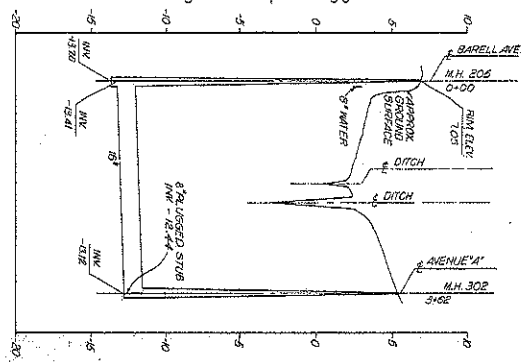


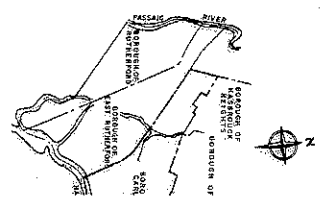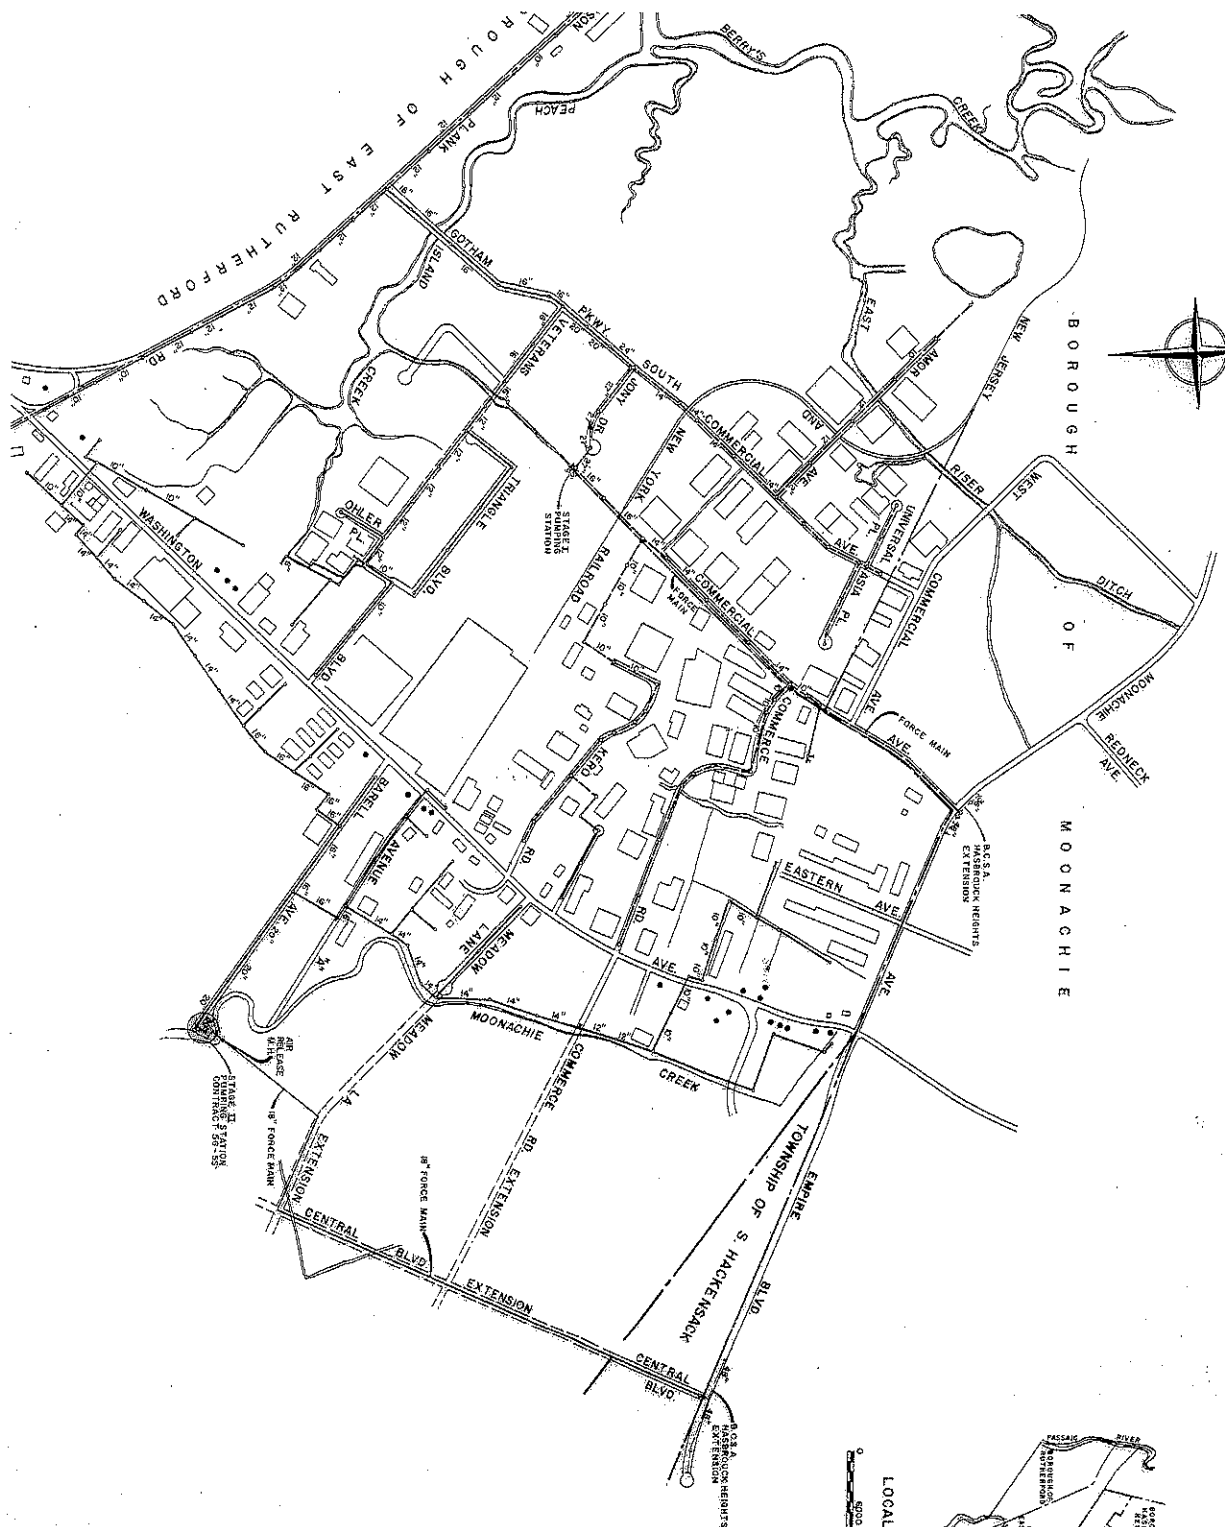

LOCALITY MAP
 0 500 1000

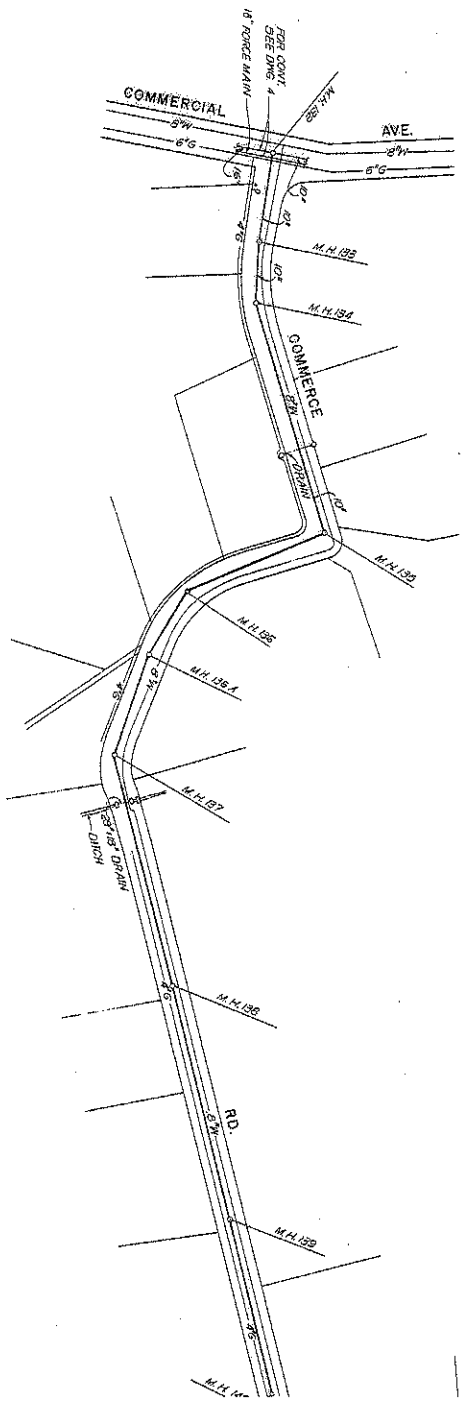


PLAN

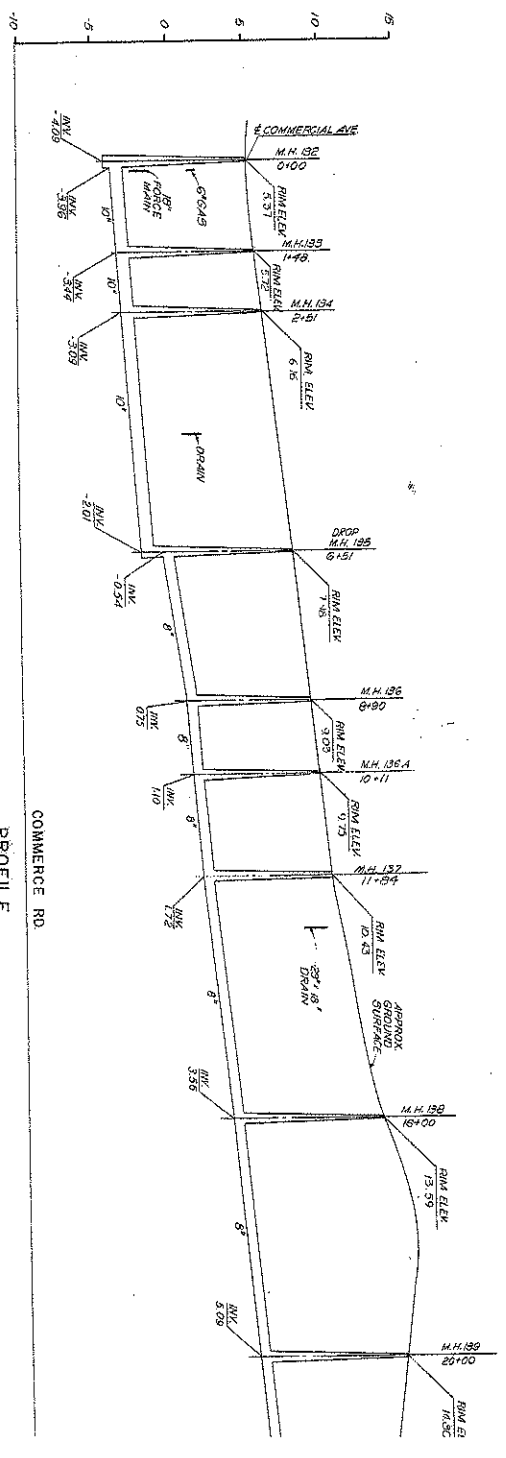


PROFILE



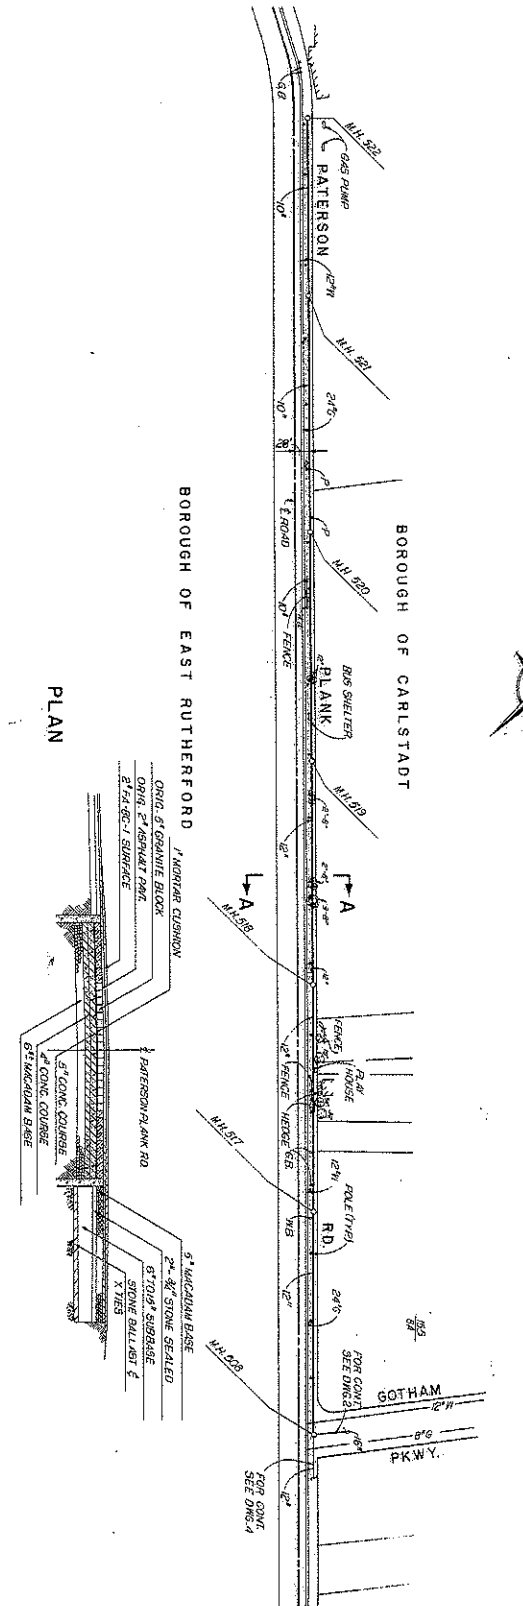

PLAN


TYPICAL CROSS SECTION A-A
PATERSON PLANK RD.

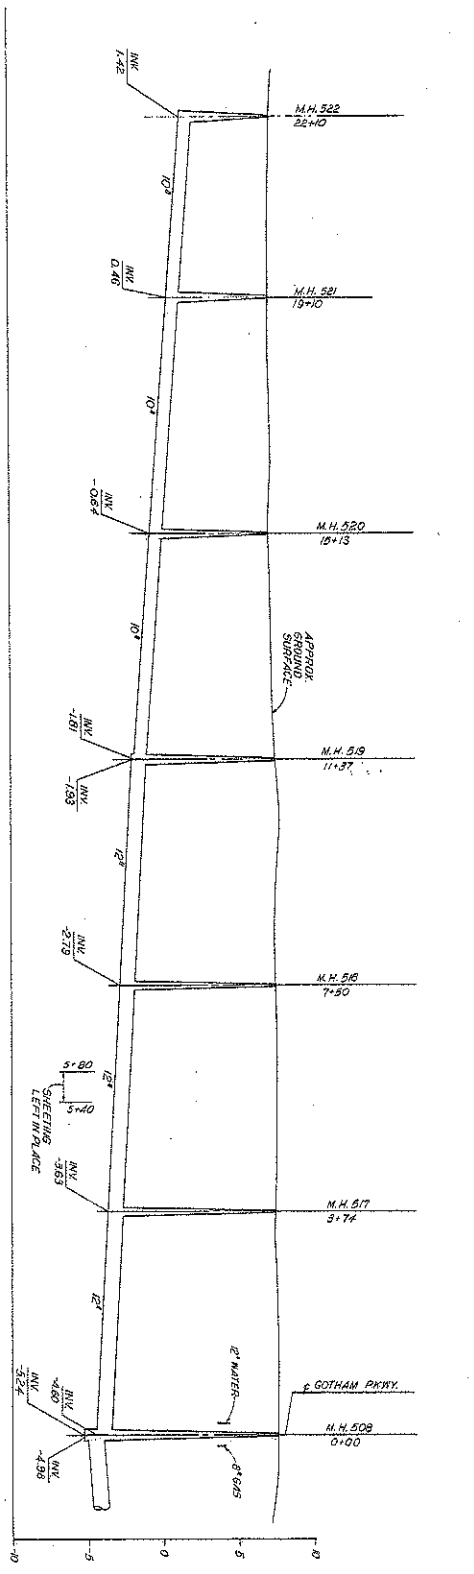


NOTE: ALL GRADING AND BELOW GROUND ELEVATIONS
OBTAINED FROM FIELD SURVEY WITH FOUNDATION
INTERVAL BETWEEN M.H. 519 & 522



PROFILE



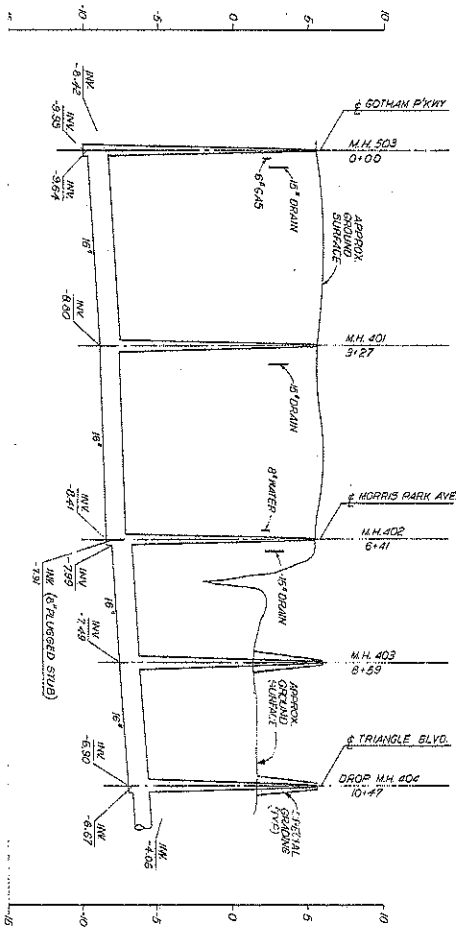


PLAN

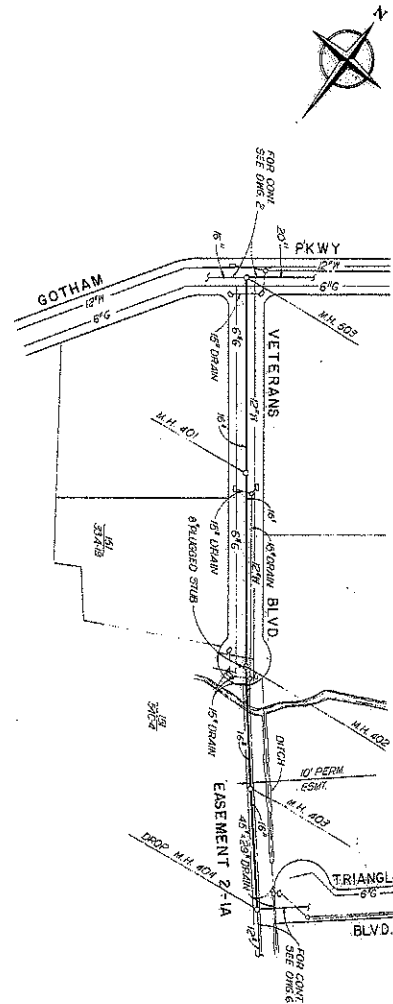


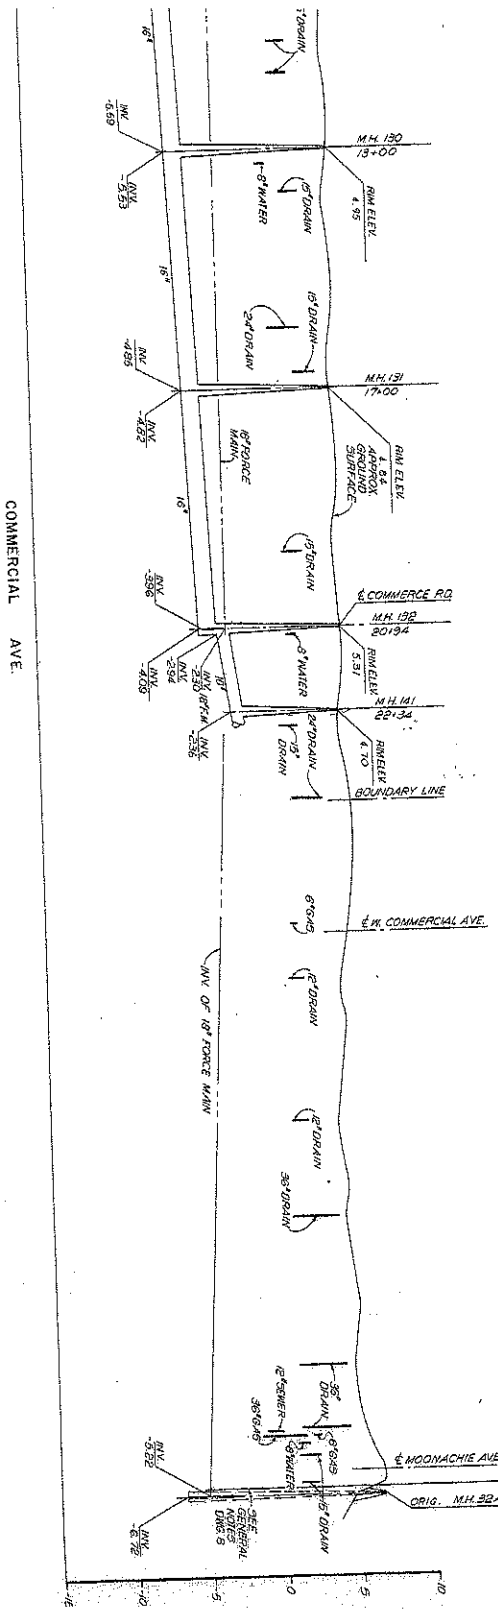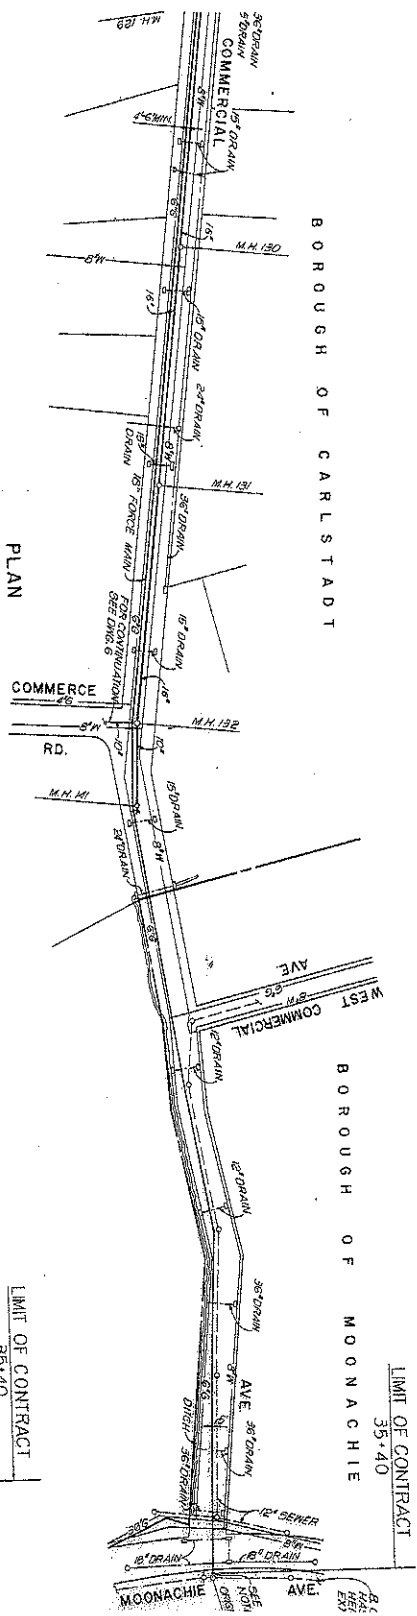


COMMERCIAL AVE.
PROFILE

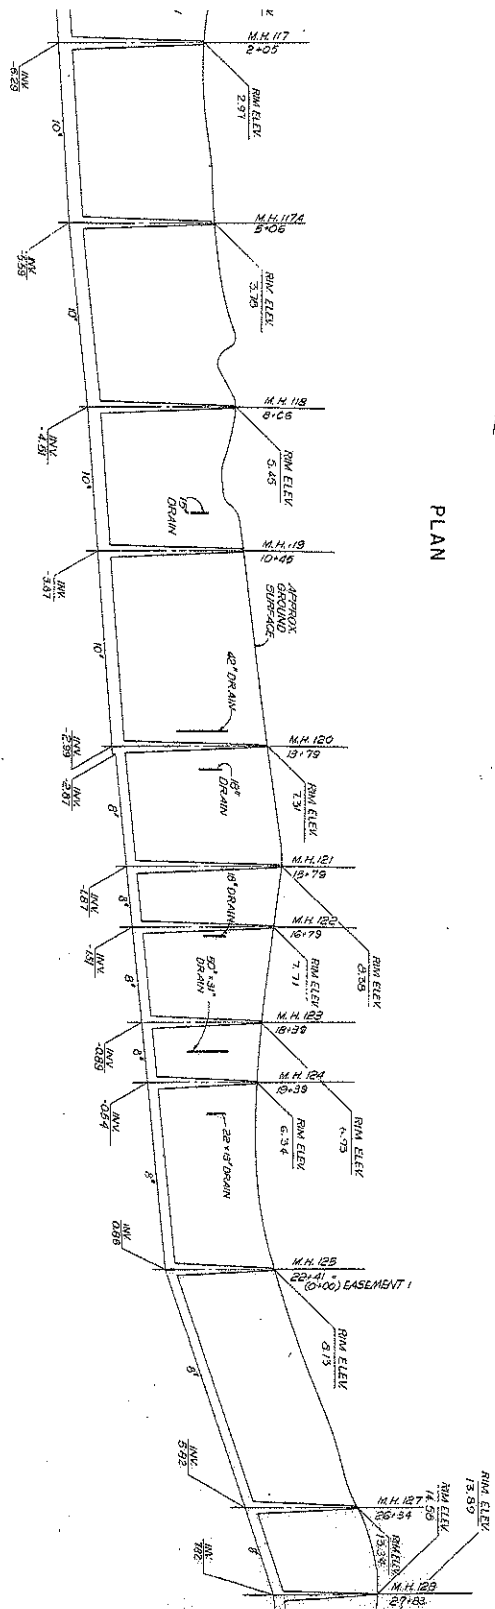

PLAN

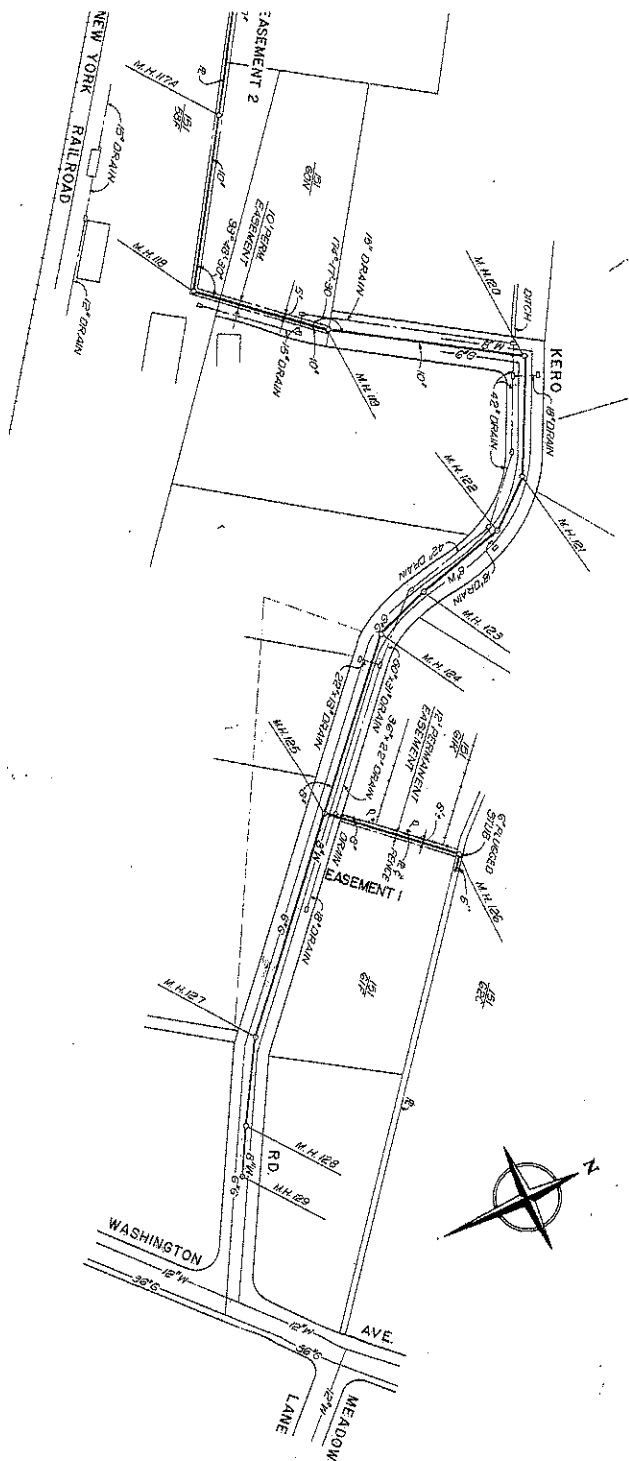

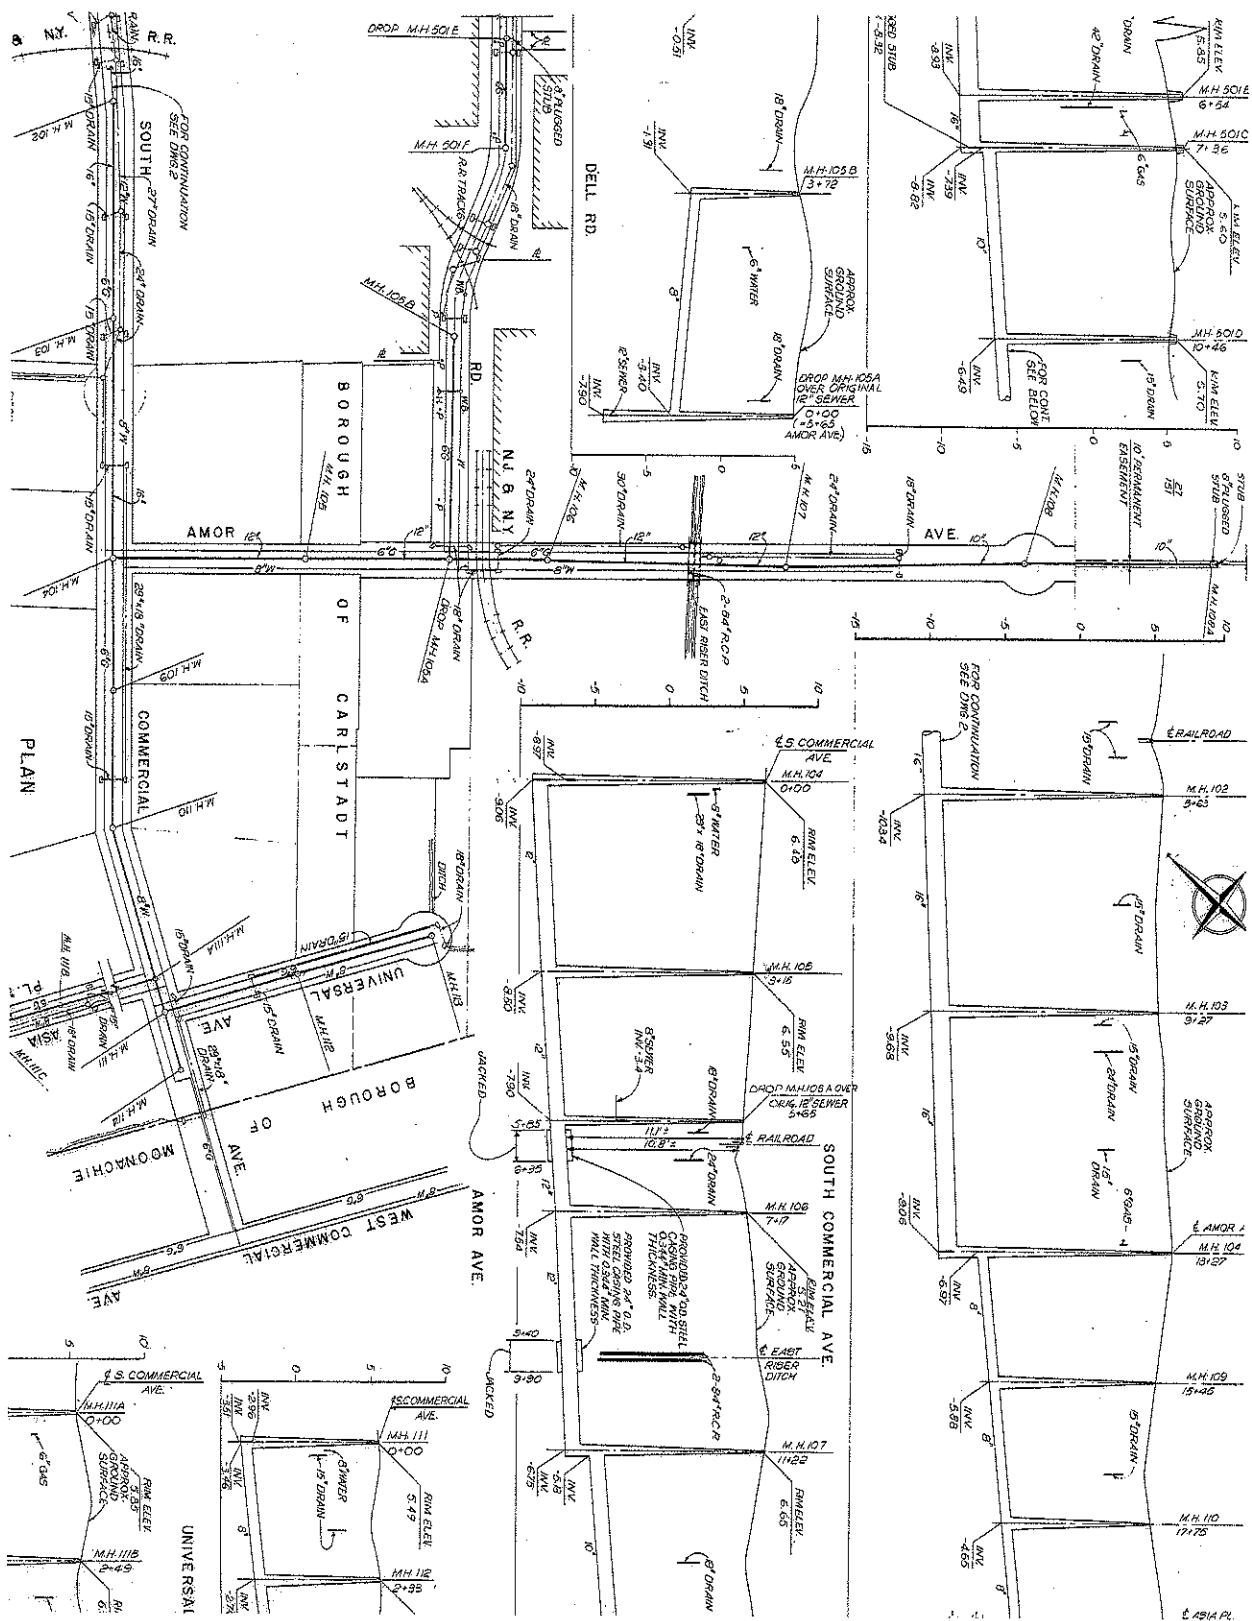



PLAN

BOROUGH OF CARLSTADT



BOROUGH OF WEST COMMERCIAL

PLAN

1/24 P.

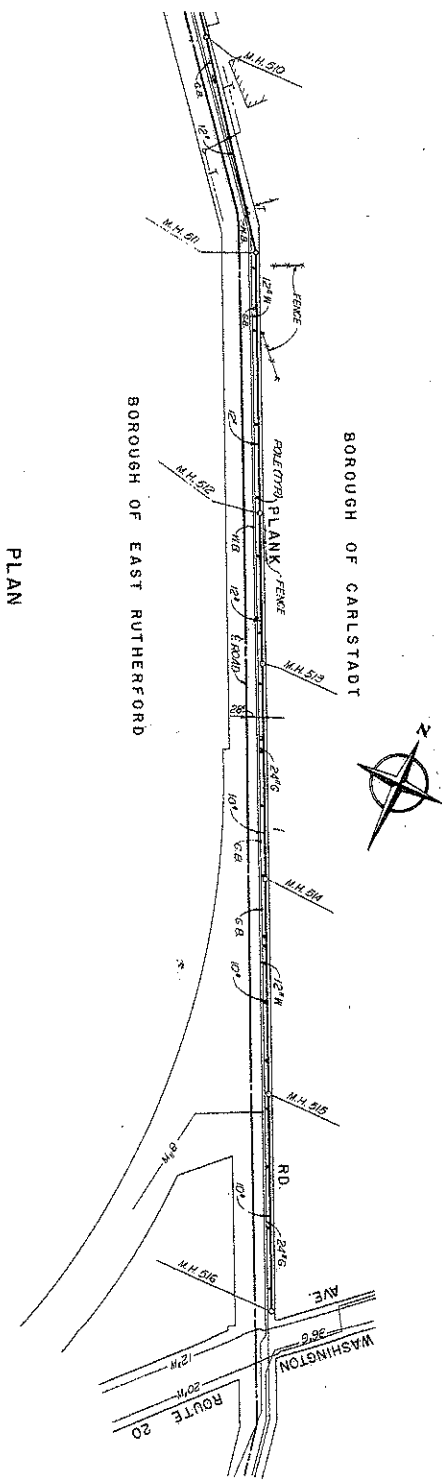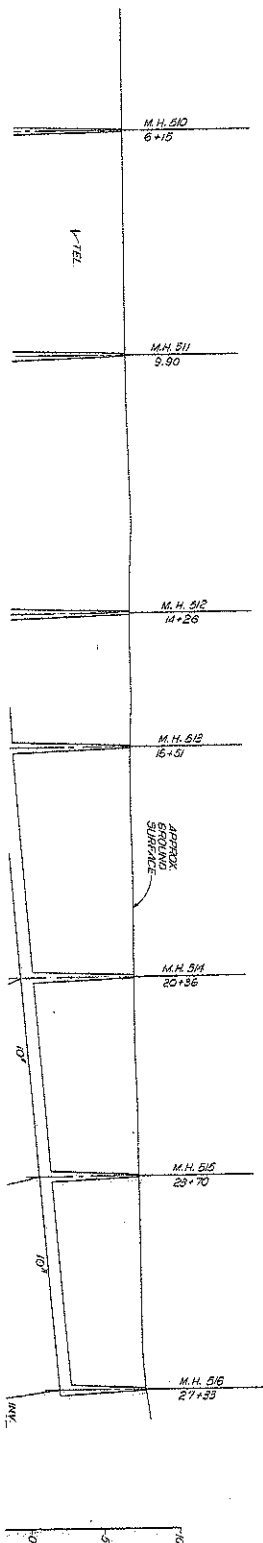


PLAN


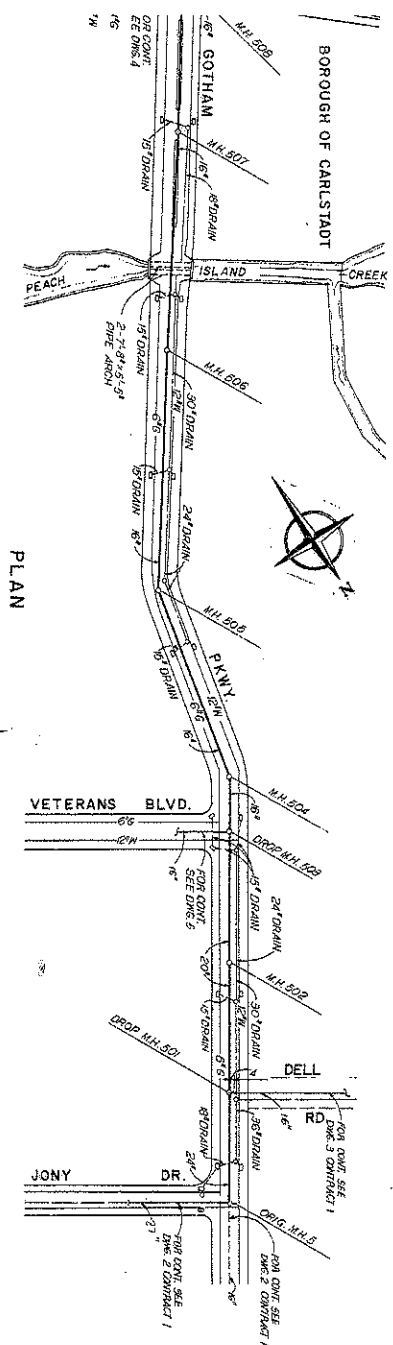
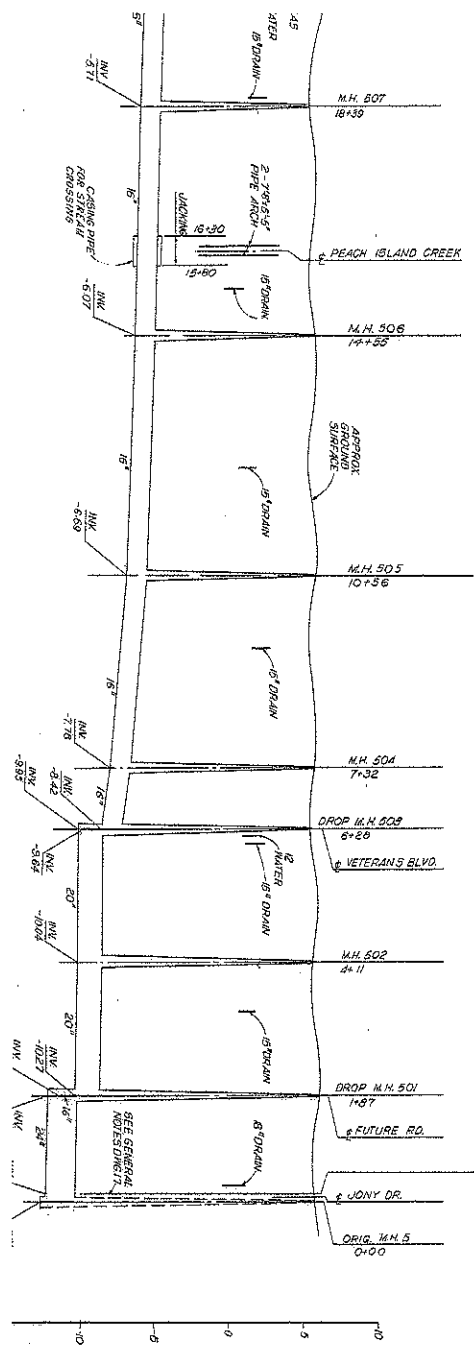


PLAN

CARLSTAL RECORD DRAWING-APRIL, 1973	APPROVED BY: <i>[Signature]</i> DATE: M. 1973	DESIGNED: M.L./M.S. DRAWN: E.A. CHECKED: M.E.	CLINTON ROBERT ASSOCIATES CONSULTING ENGINEERS
	63+1 10' 0"		

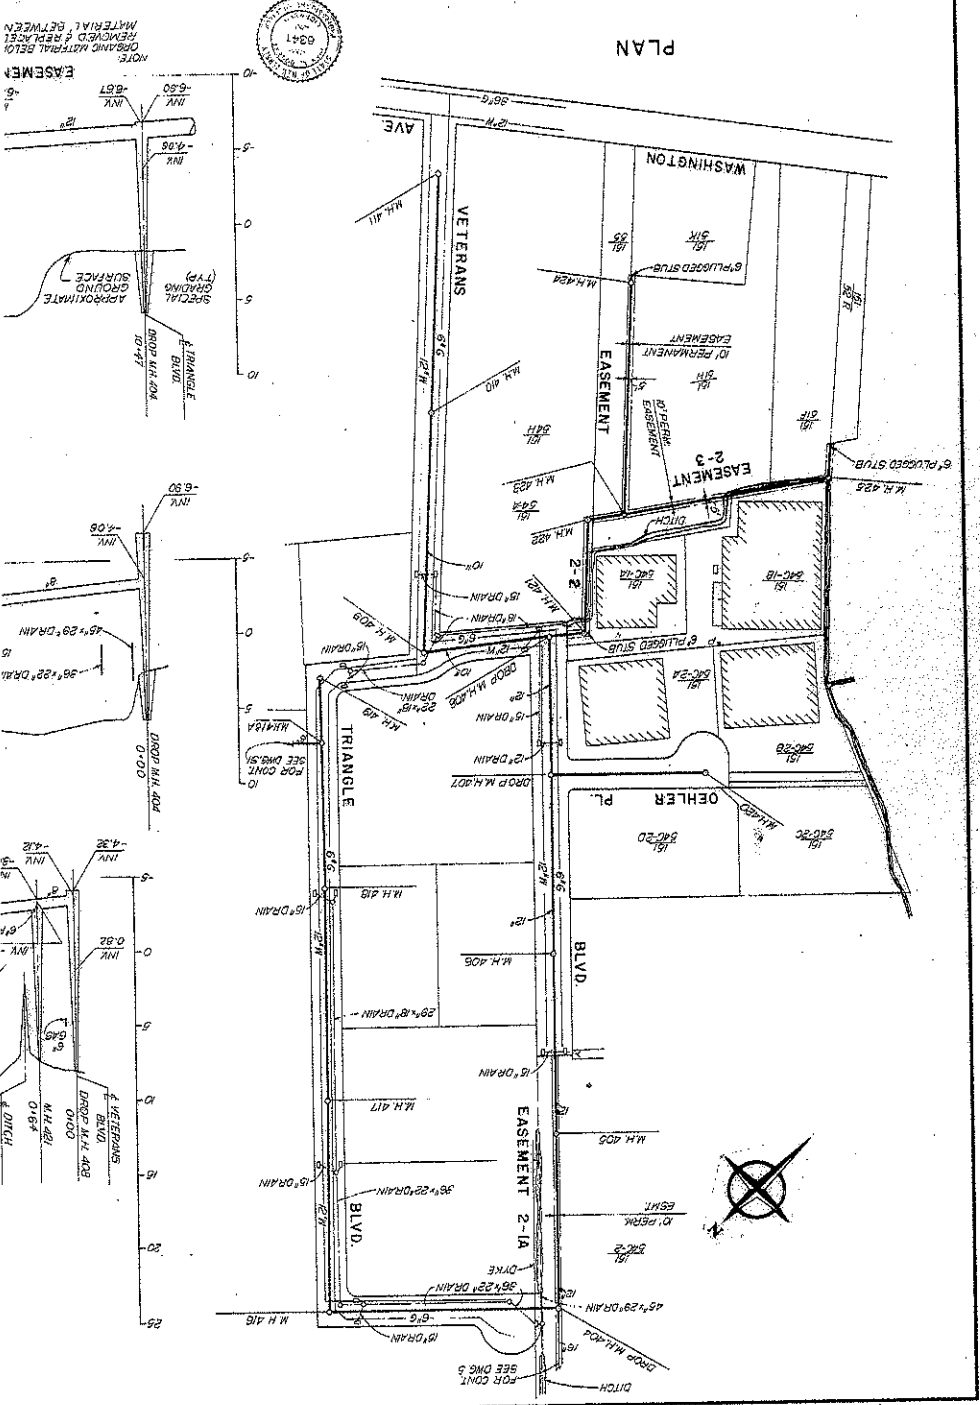

NOTES:
 REMOVING MATERIAL BELOW
 MATERIAL BETWEEN
 EASEMENT

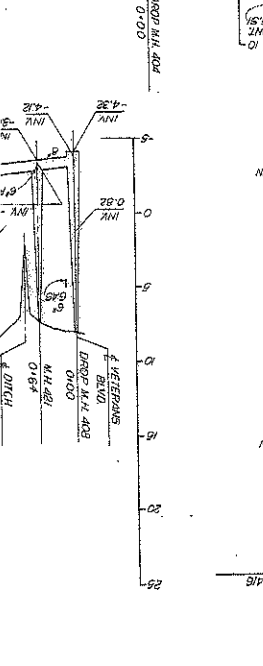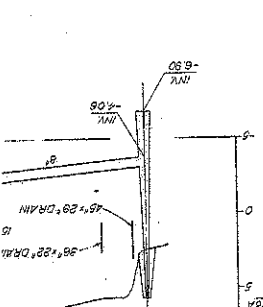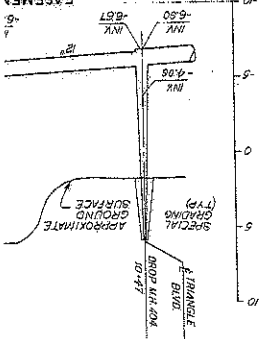



PLAN

MOONACHIE BOROUGH OF MOONACHIE AVE.




COMMERCIAL AVE.


EASTERN AVE.

WASHINGTON

TERMINAL LA CREEK

MOONACHIE

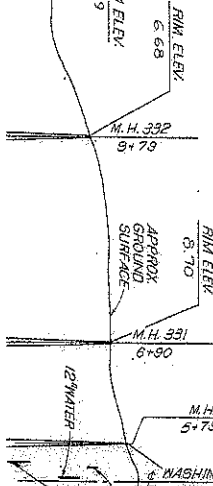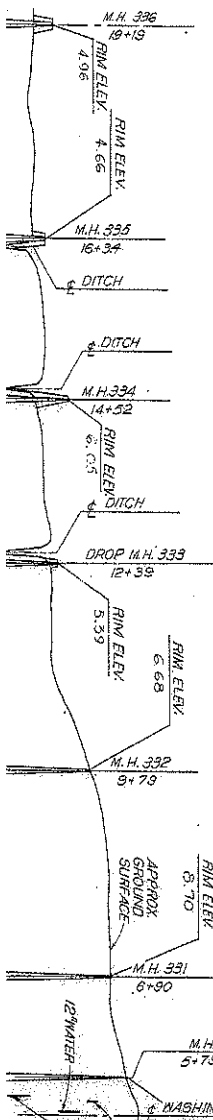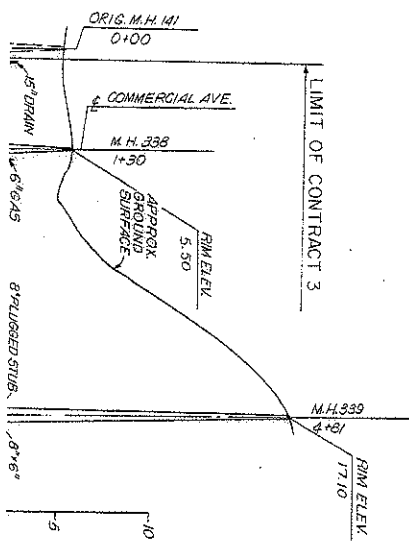

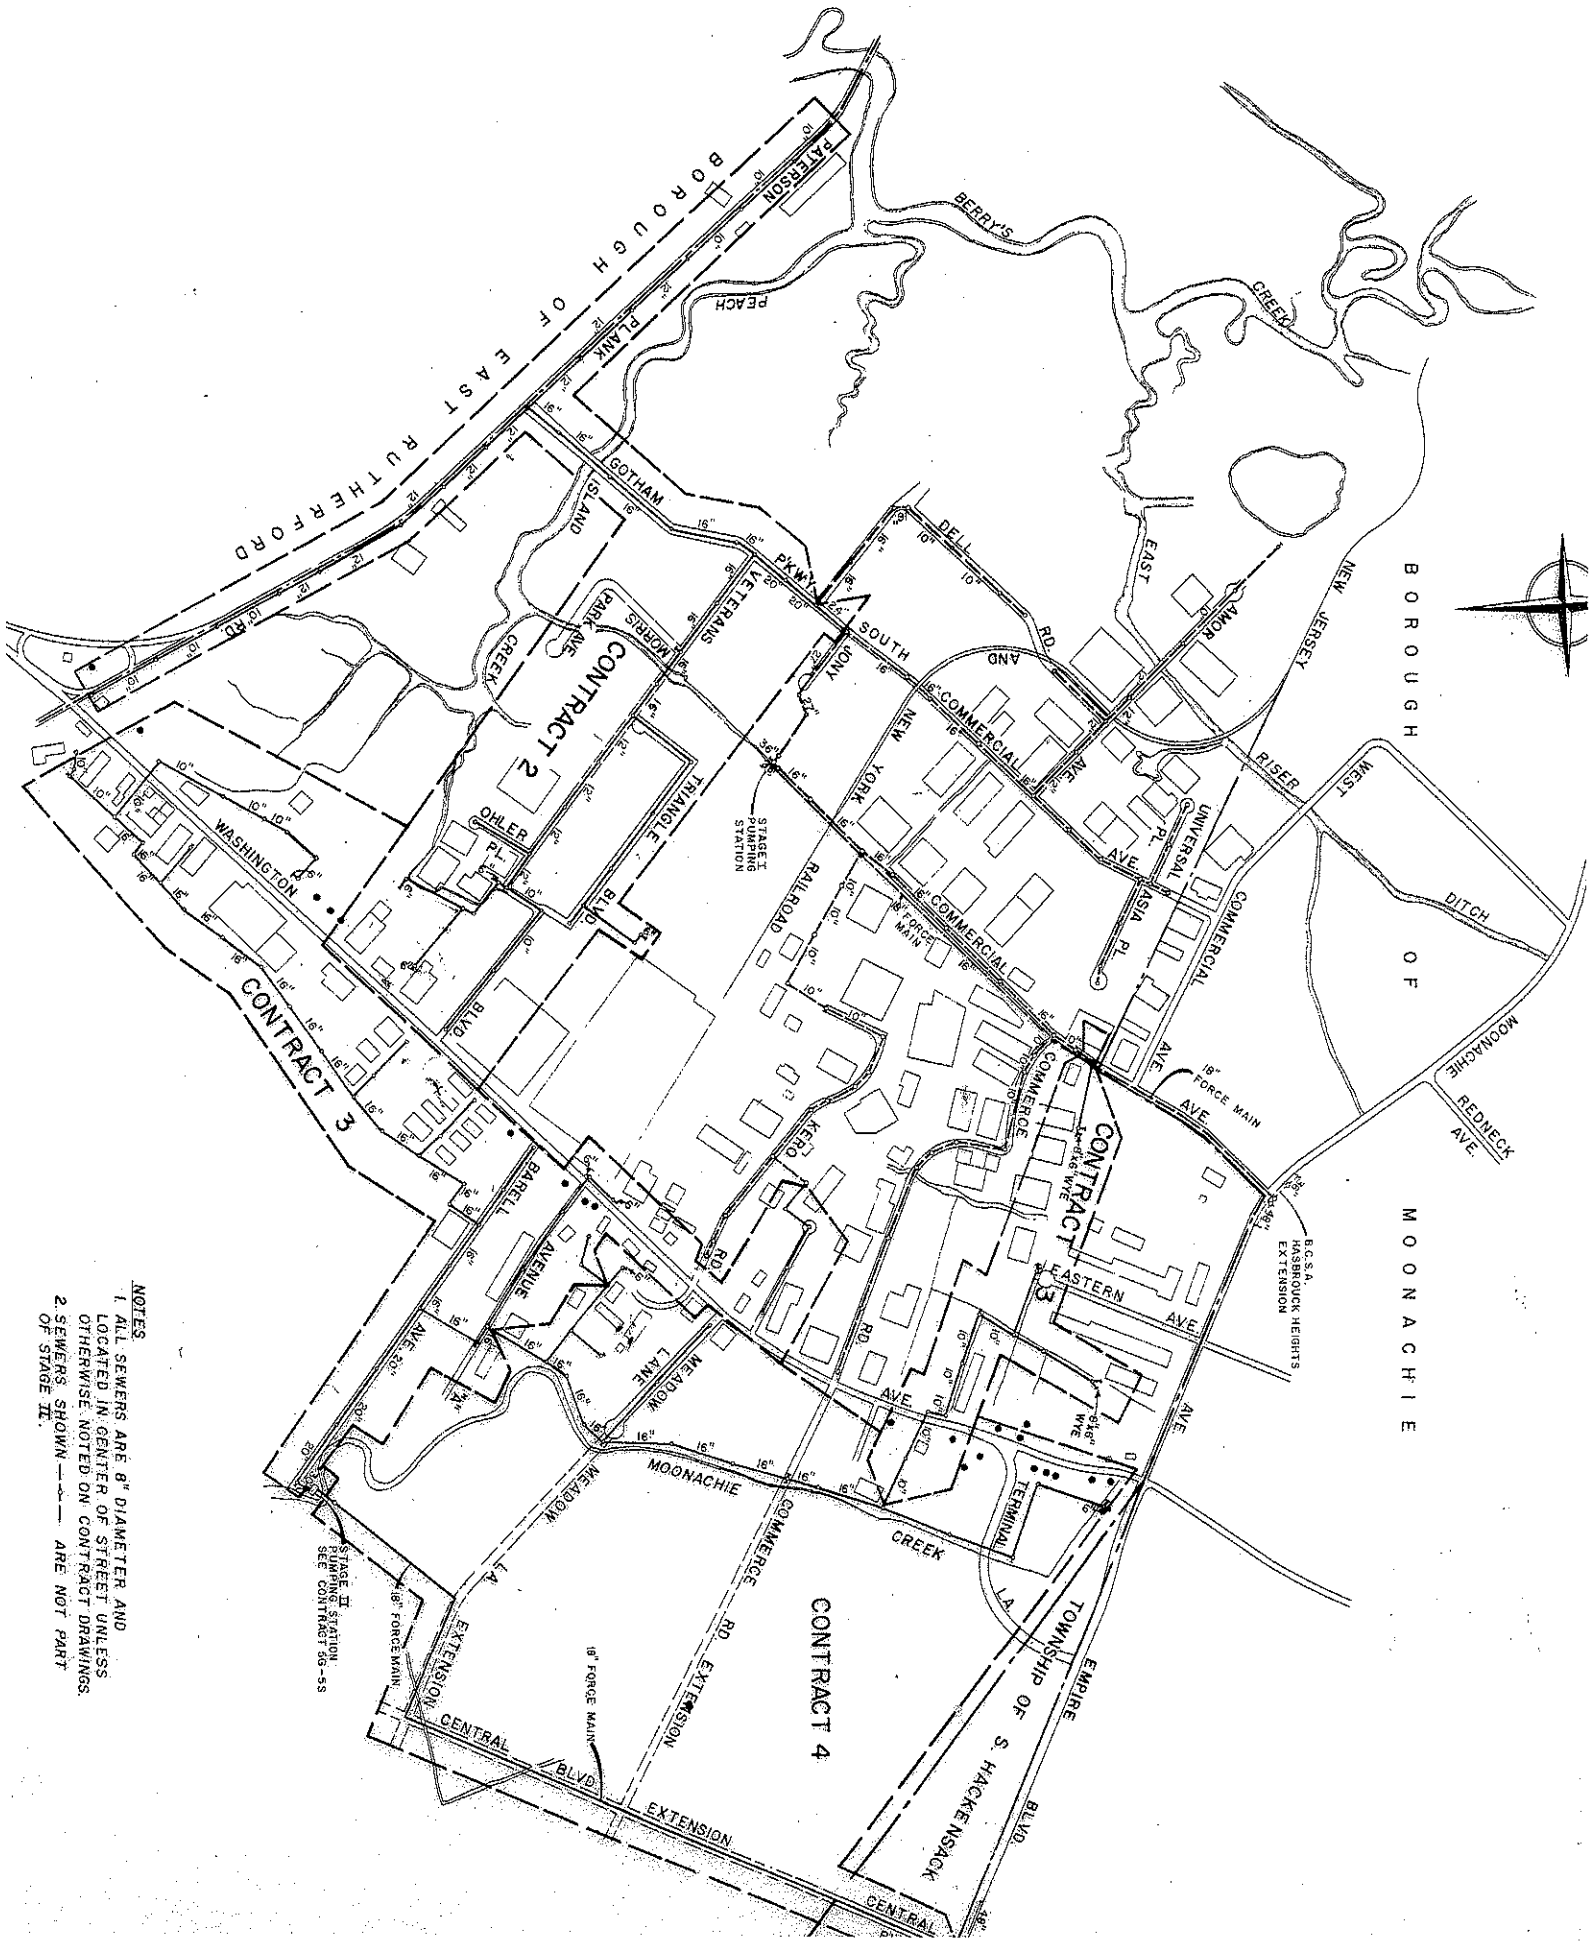



NOTES
 1. ALL SEWERS ARE 8" DIAMETER AND LOCATED IN CENTER OF STREET UNLESS OTHERWISE NOTED ON CONTRACT DRAWINGS.
 2. SEWERS SHOWN WITH DASHED LINES ARE NOT PART OF STAGE II.

STAGE II
 RAMPING STATION
 SEE CONTRACTS 30-33

B.C.S.A.
 HENRIK HEHRITS
 EXTENSION

BOROUGH OF EAST RUTHERFORD
 BOROUGH OF MOONACHIE

CONTRACT 1
 CONTRACT 2
 CONTRACT 3
 CONTRACT 4

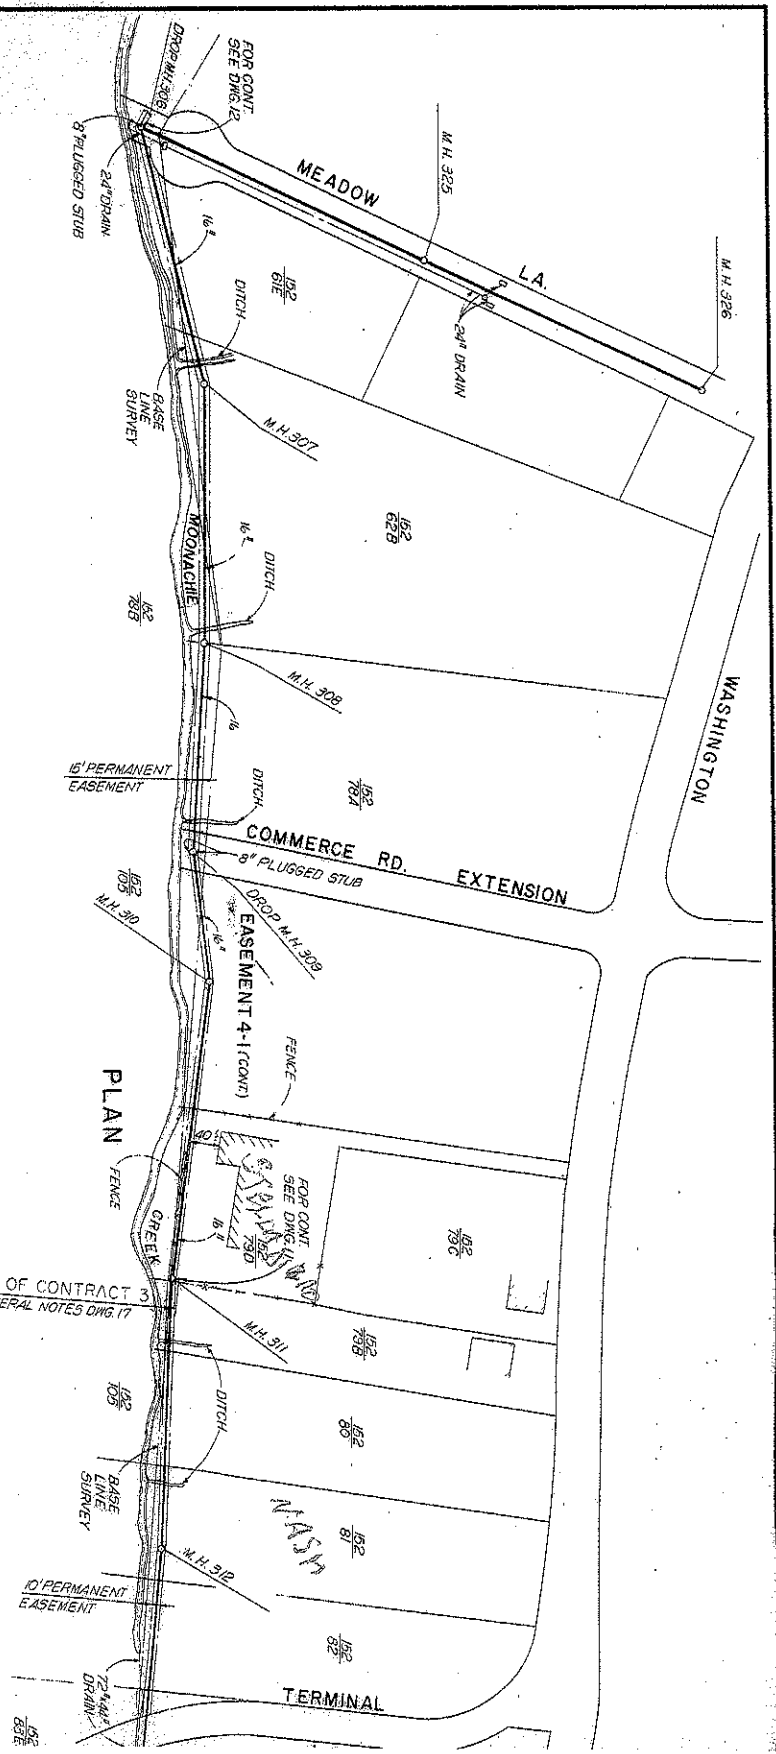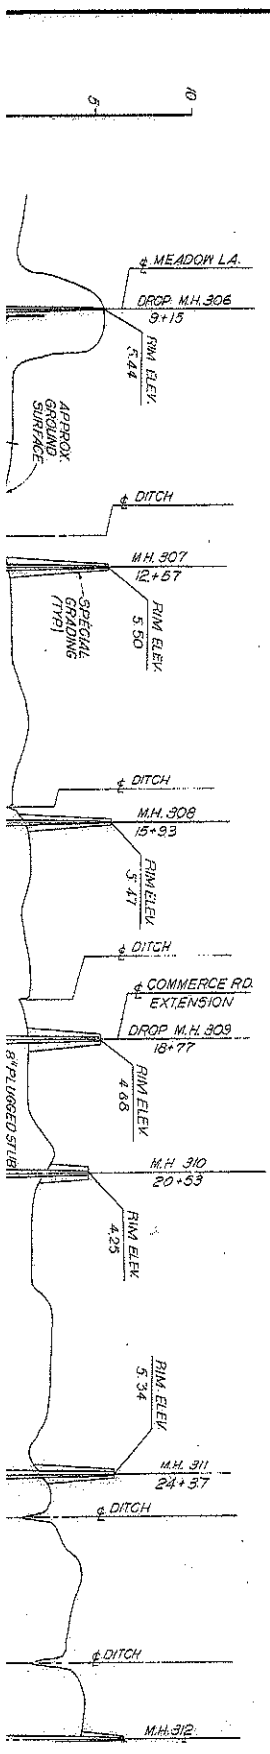

07
7

108


MERCER RD
EXTENSION
M.H. 309
77

310
33

311
37


ALLA

MEADOW

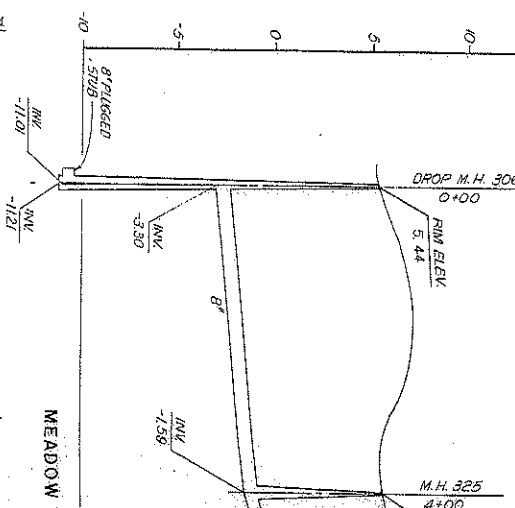


LIMIT OF CONTRACT 3
SEE GENERAL NOTES DWG. 17

PLAN


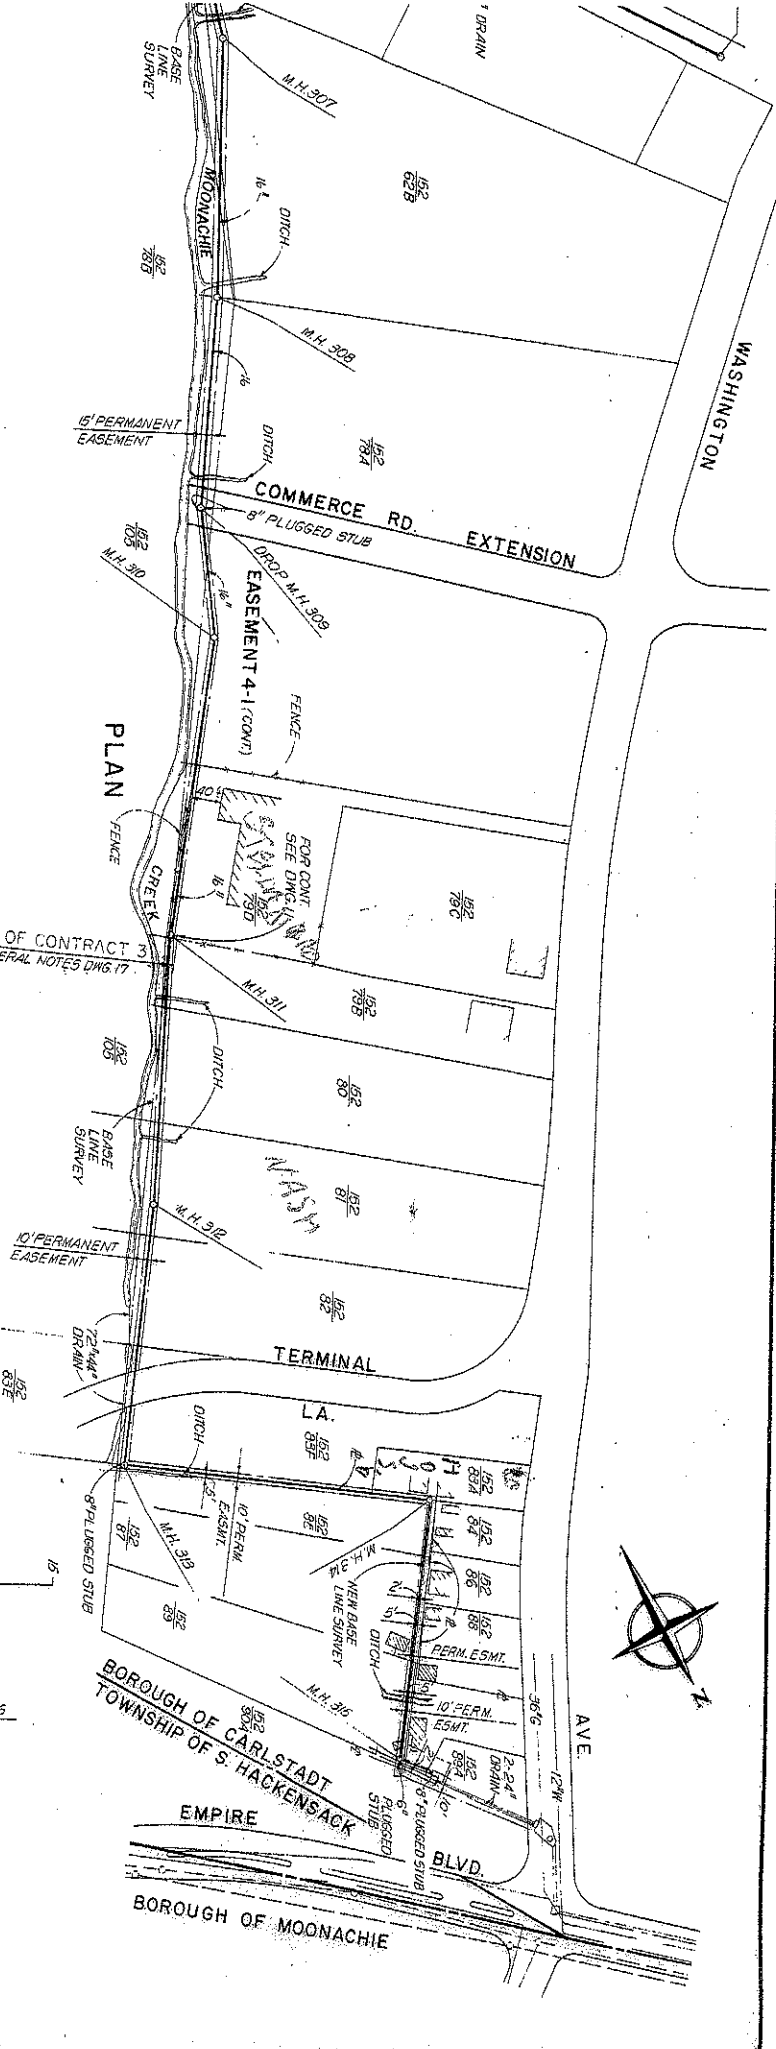


BOROUGH OF CARLSTADT
TOWNSHIP OF S. HACKENSACK




BOROUGH OF MOONACHIE

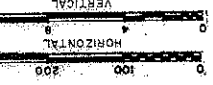

EASEMENT 4-1

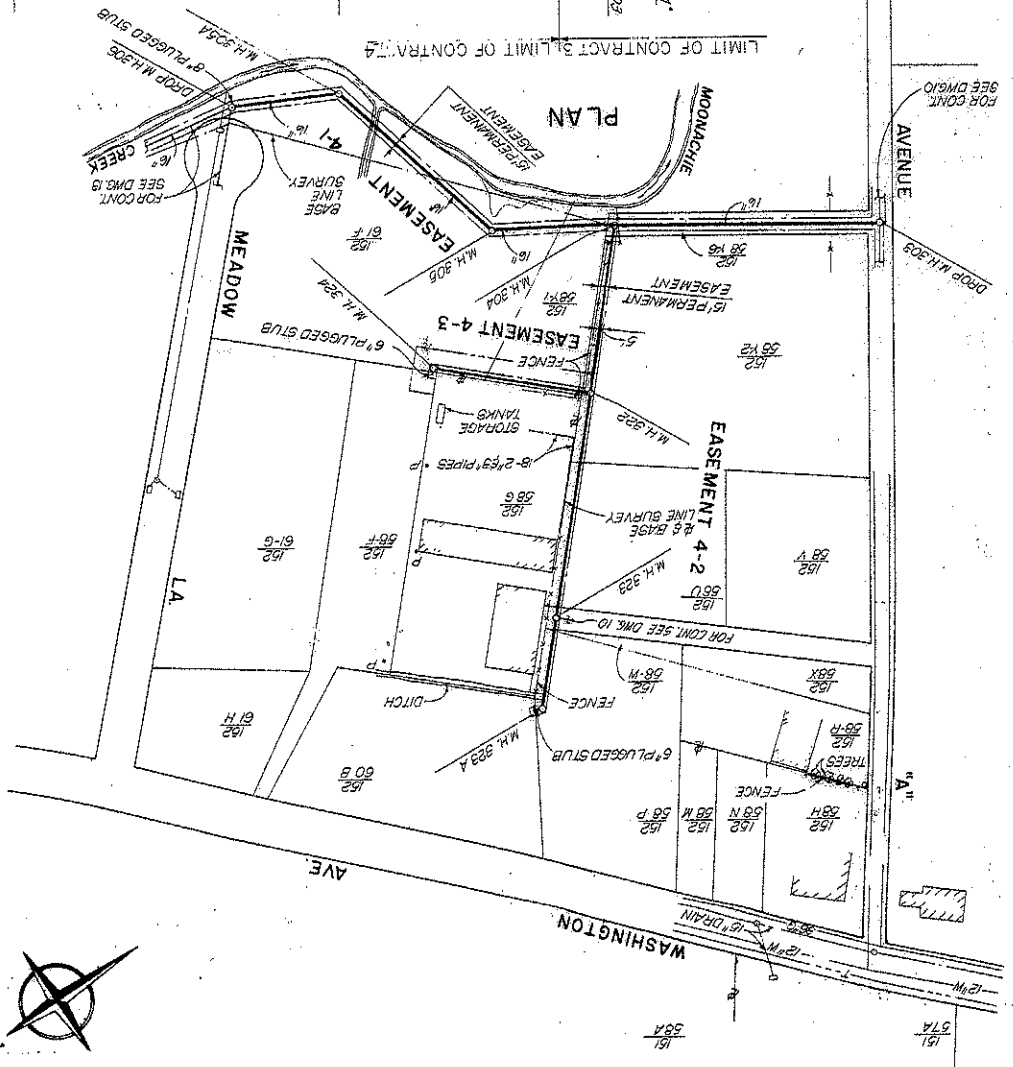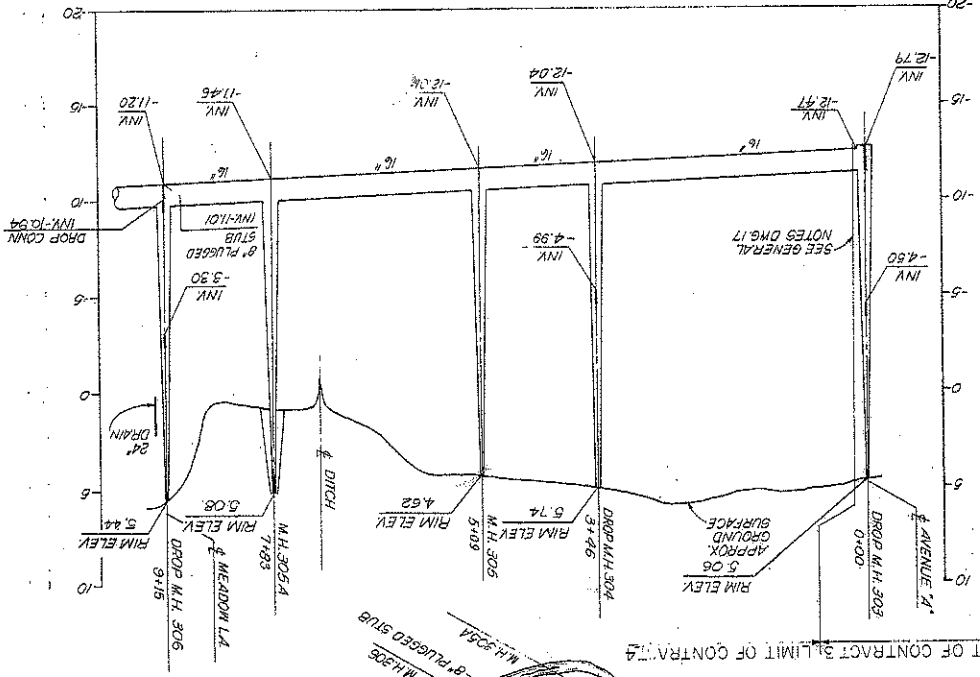

PROFILES

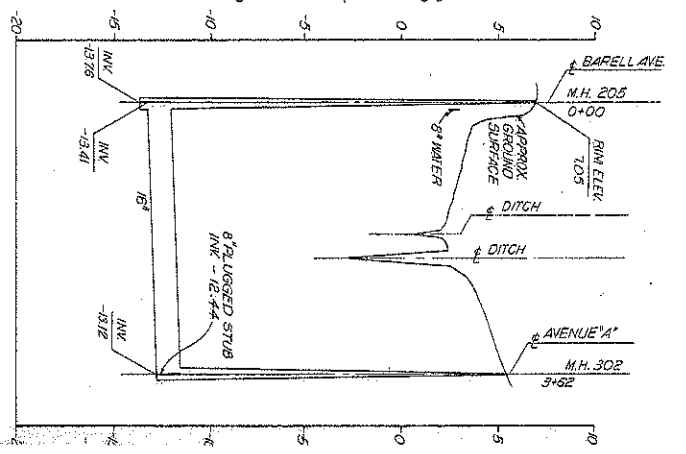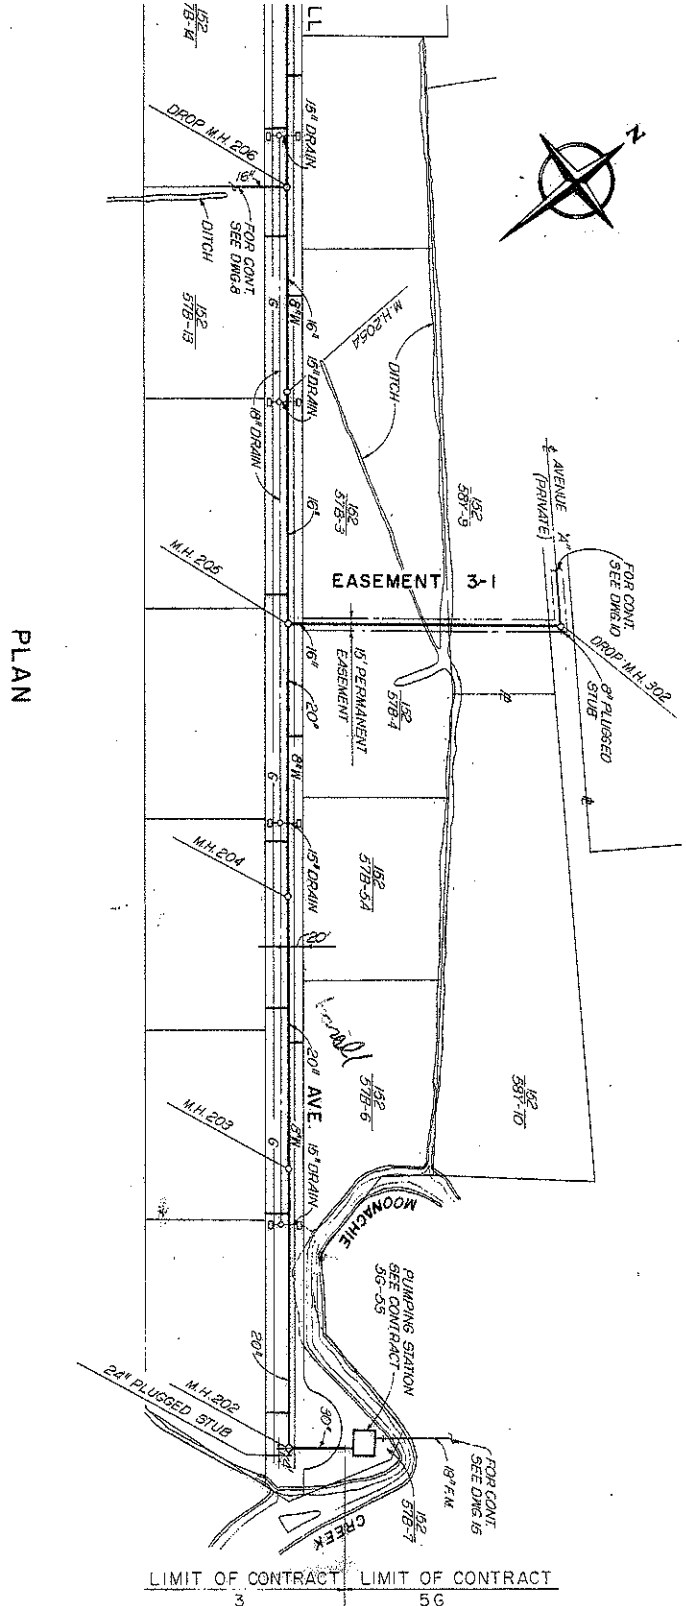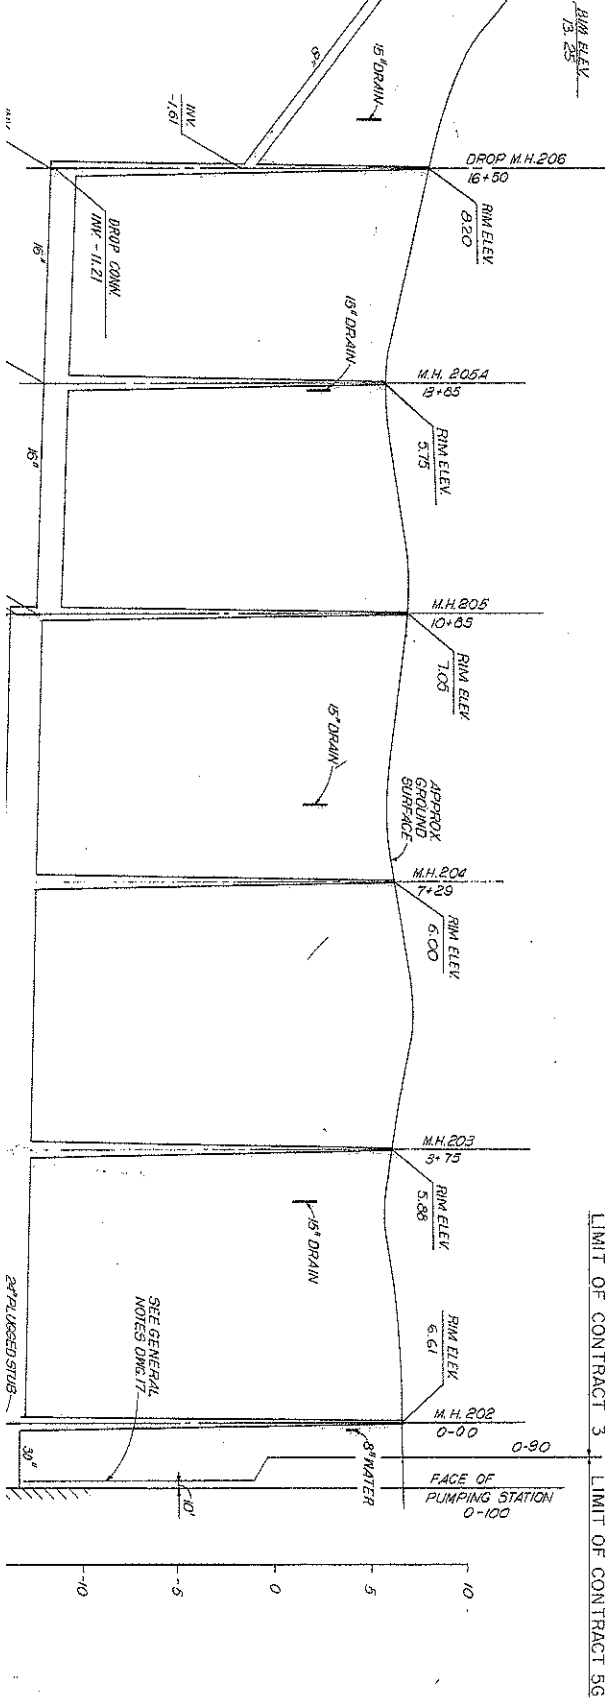

SEWERAGE SYSTEM
STAGE II

PLAN AND PROFILE

CONTRACT 4
RECORD DRAWING 15

PLAN

